


RECEIVED

AUG 21 1975

WATER RESOURCES DEPT
SALEM, OREGON

Application No. 53566
Permit No. 40082

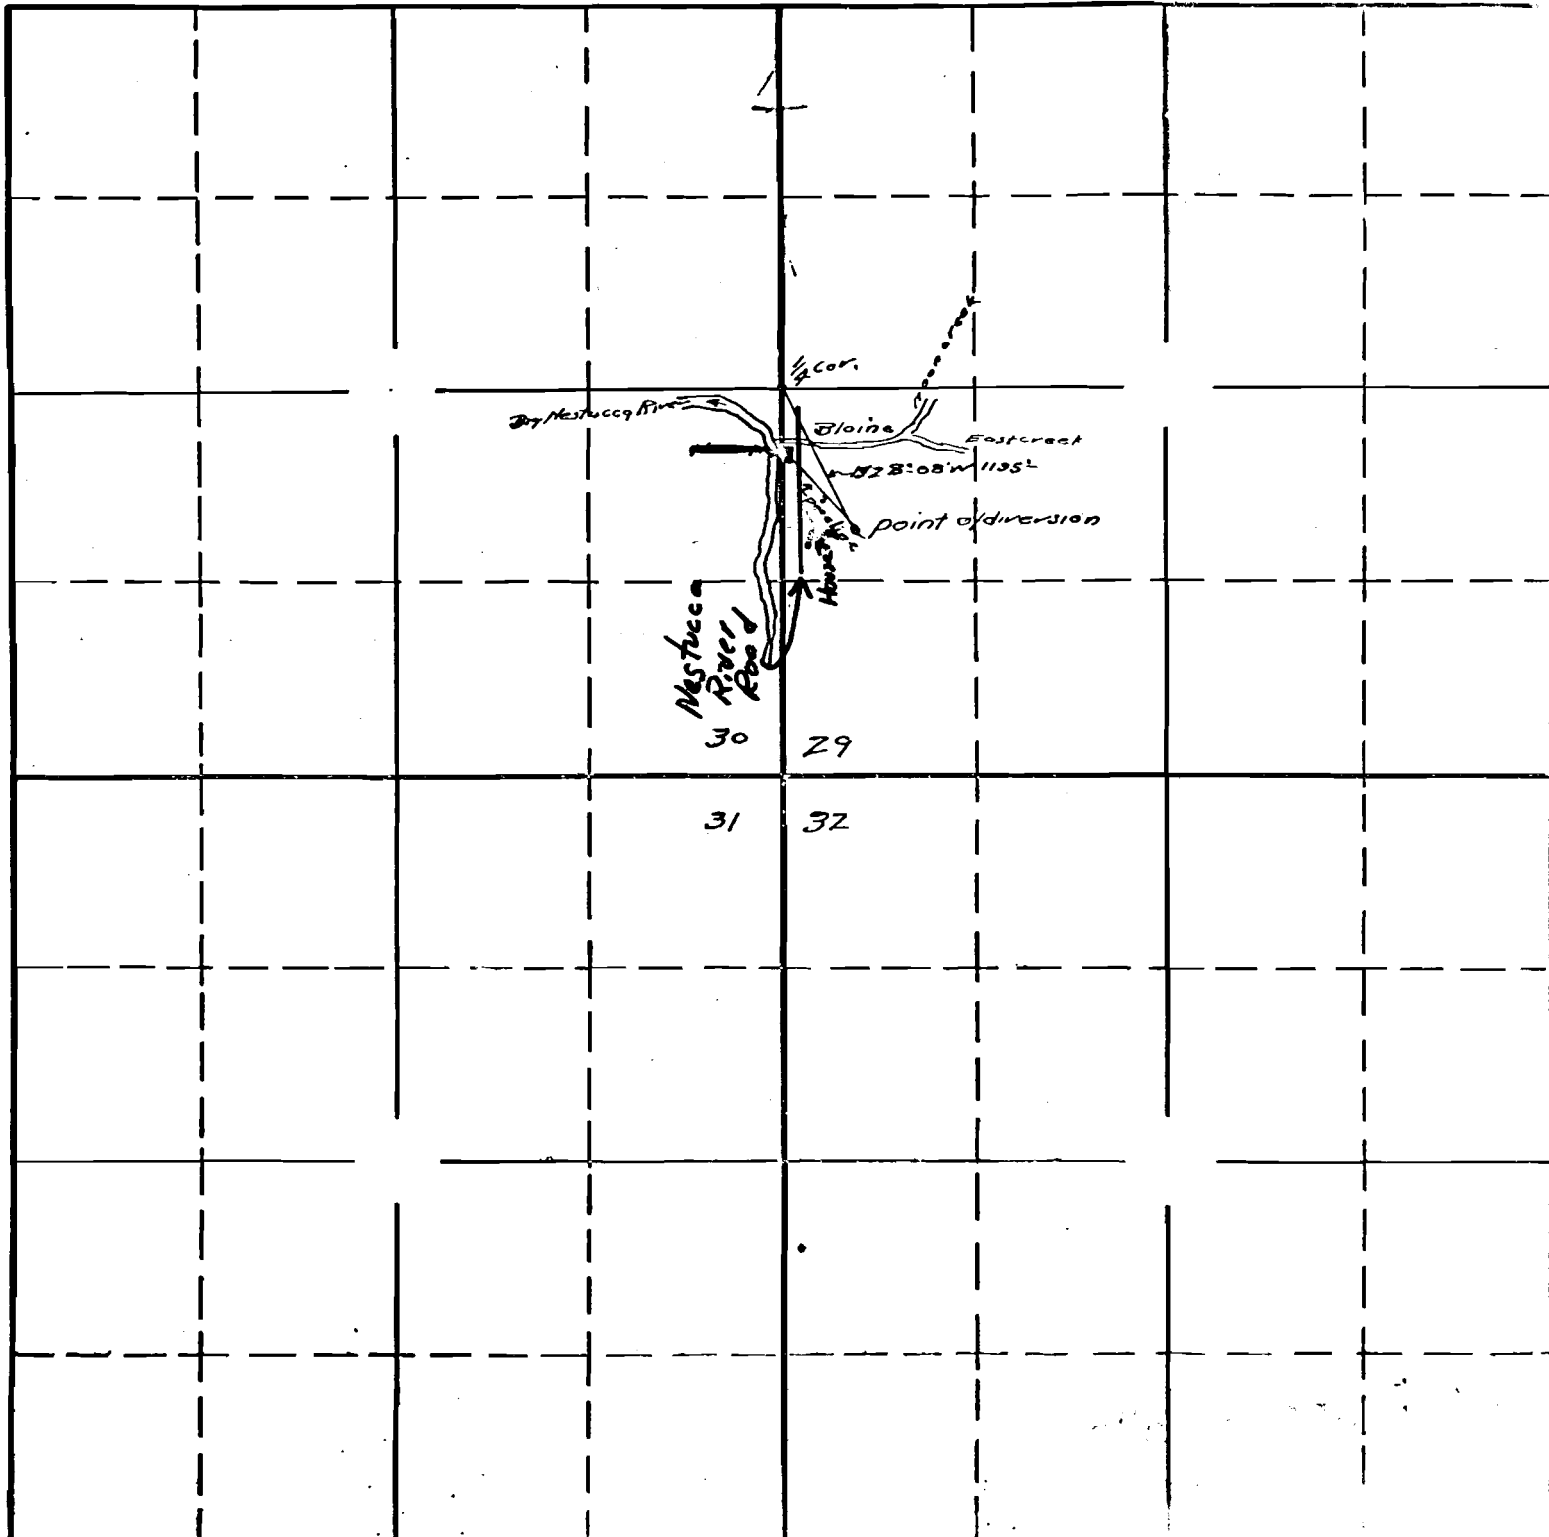

Sec. 29

Tp. 35

R. 8. W