


T.35. R.2W. W.M.

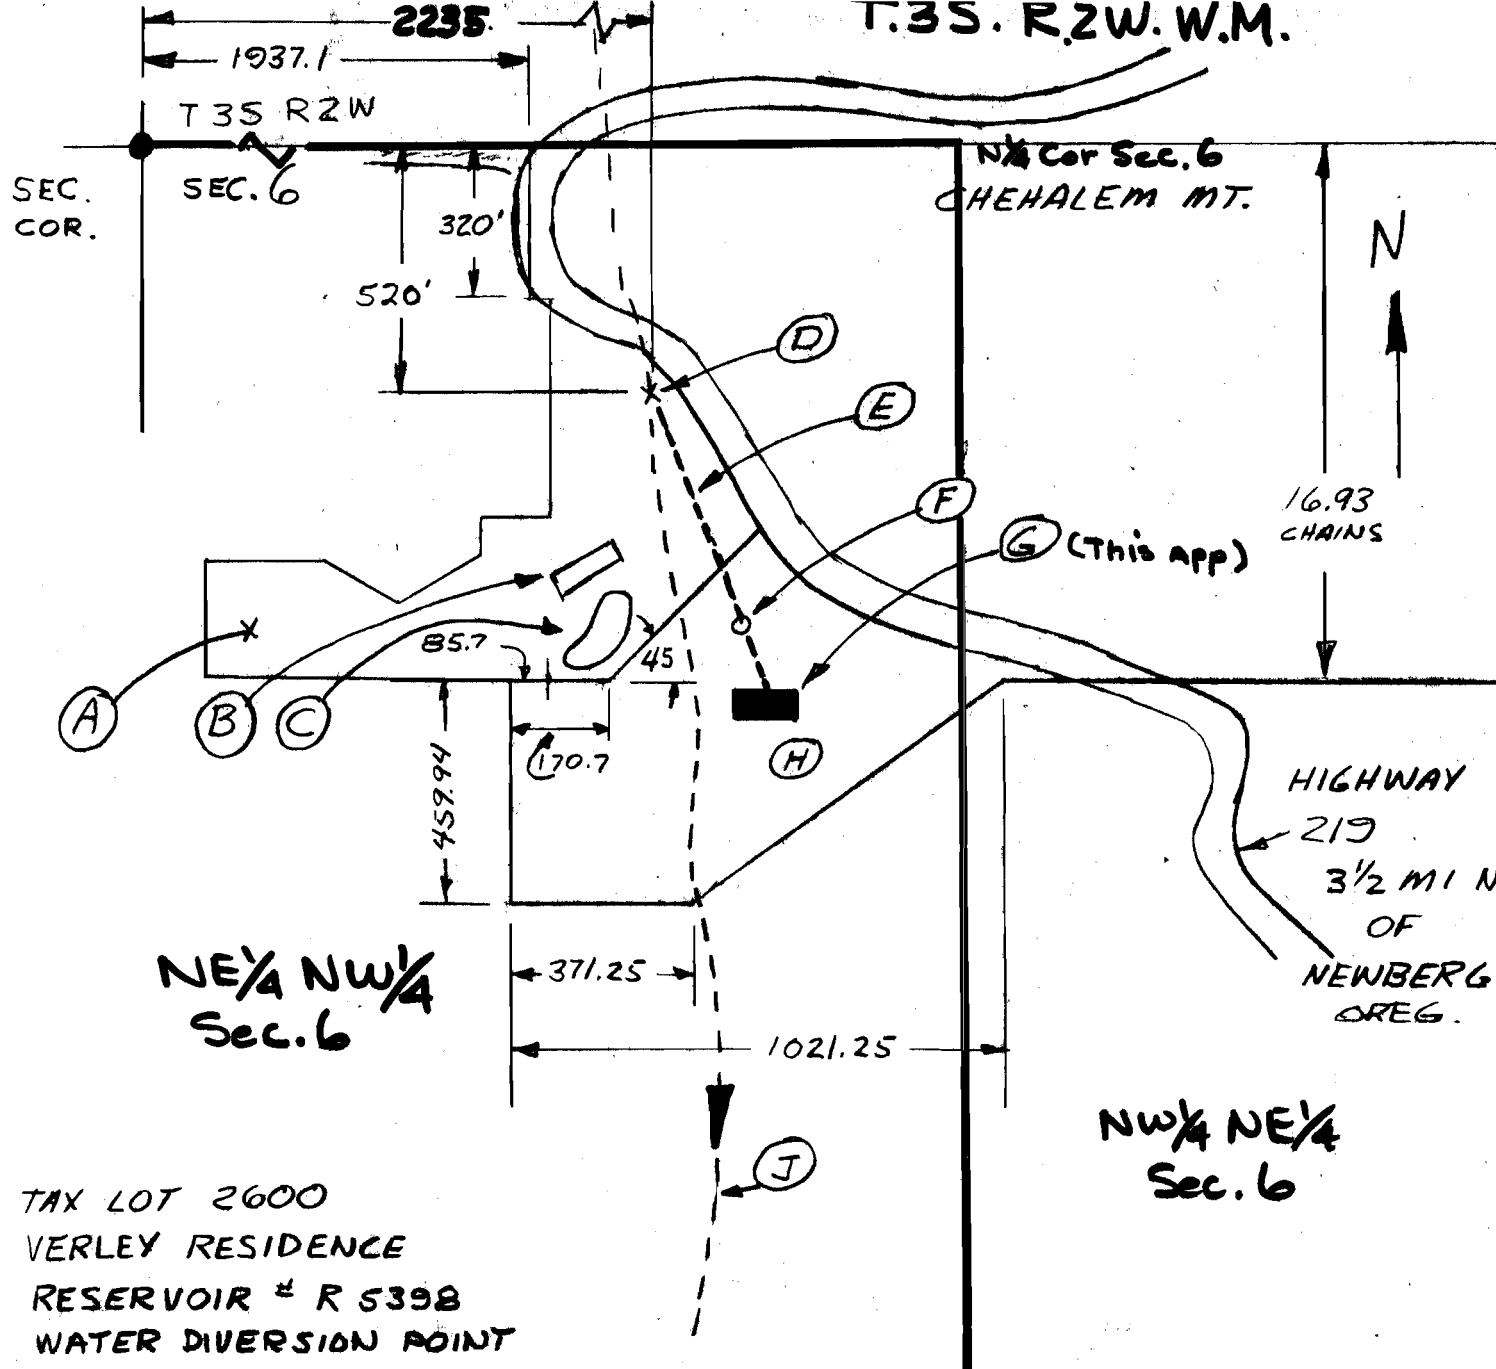

- (A) TAX LOT 2600
- (B) VERLEY RESIDENCE
- (C) RESERVOIR # R 5398
- (D) WATER DIVERSION POINT
- (E) 1" PIPE LINE
- (F) 1000 GAL RESERVOIR
- (G) VERLEY HOME (NEW)
- (H) TAX LOT 2400 (PARTIAL)
- (J) CREEK

**Application No. 53630**  
**Permit No. 40119**

REFER TO COUNTY MAP  
 3-2-06  
 AERIAL 3DD-30

DOMESTIC WATER APPL.  
 DONALD W. VERLEY  
 RT. 1 BOX 83 A  
 NEWBERG ORE. 97132

DATE 9-3-75 SCALE 1/4"  
 1" = 400'