




T. 26 S., R. 5 W., Sec. 21  
NW 1/4

NE 1/4 NW 1/4

N. 1/4 Cor.  
Sec. 21

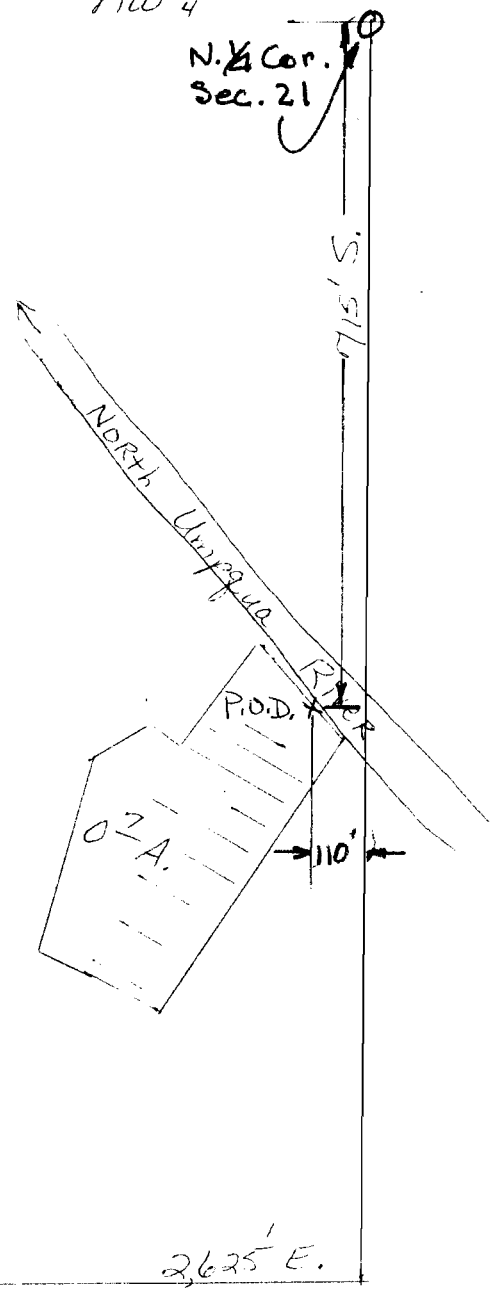

**Application No. 53624**  
**Permit No. 40126**

rec. Sept 23, 1975