


T.37S., R.5 W., W.M.

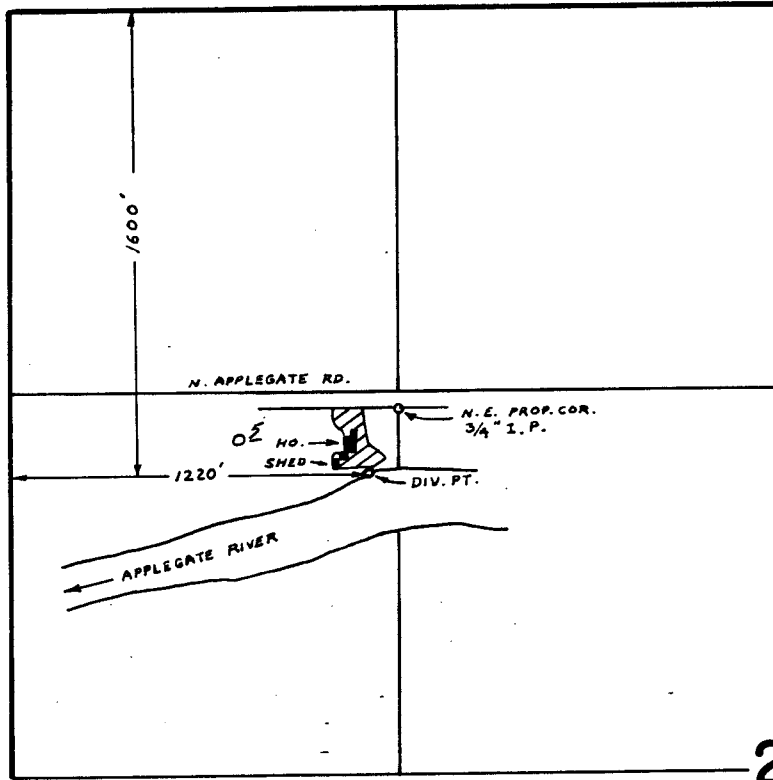

21

SCALE : 1" = 660 FT.

FINAL PROOF SURVEY
UNDER

Application No. 53837 Permit No. 40185
IN NAME OF

C. W. EILERT

Surveyed JUL. 14 1978, by B. SUND

RECEIVED
OCT 1 1981
WM. DIST. 14
GRANTS PASS, ORE

P.T.S.-1978-14-A