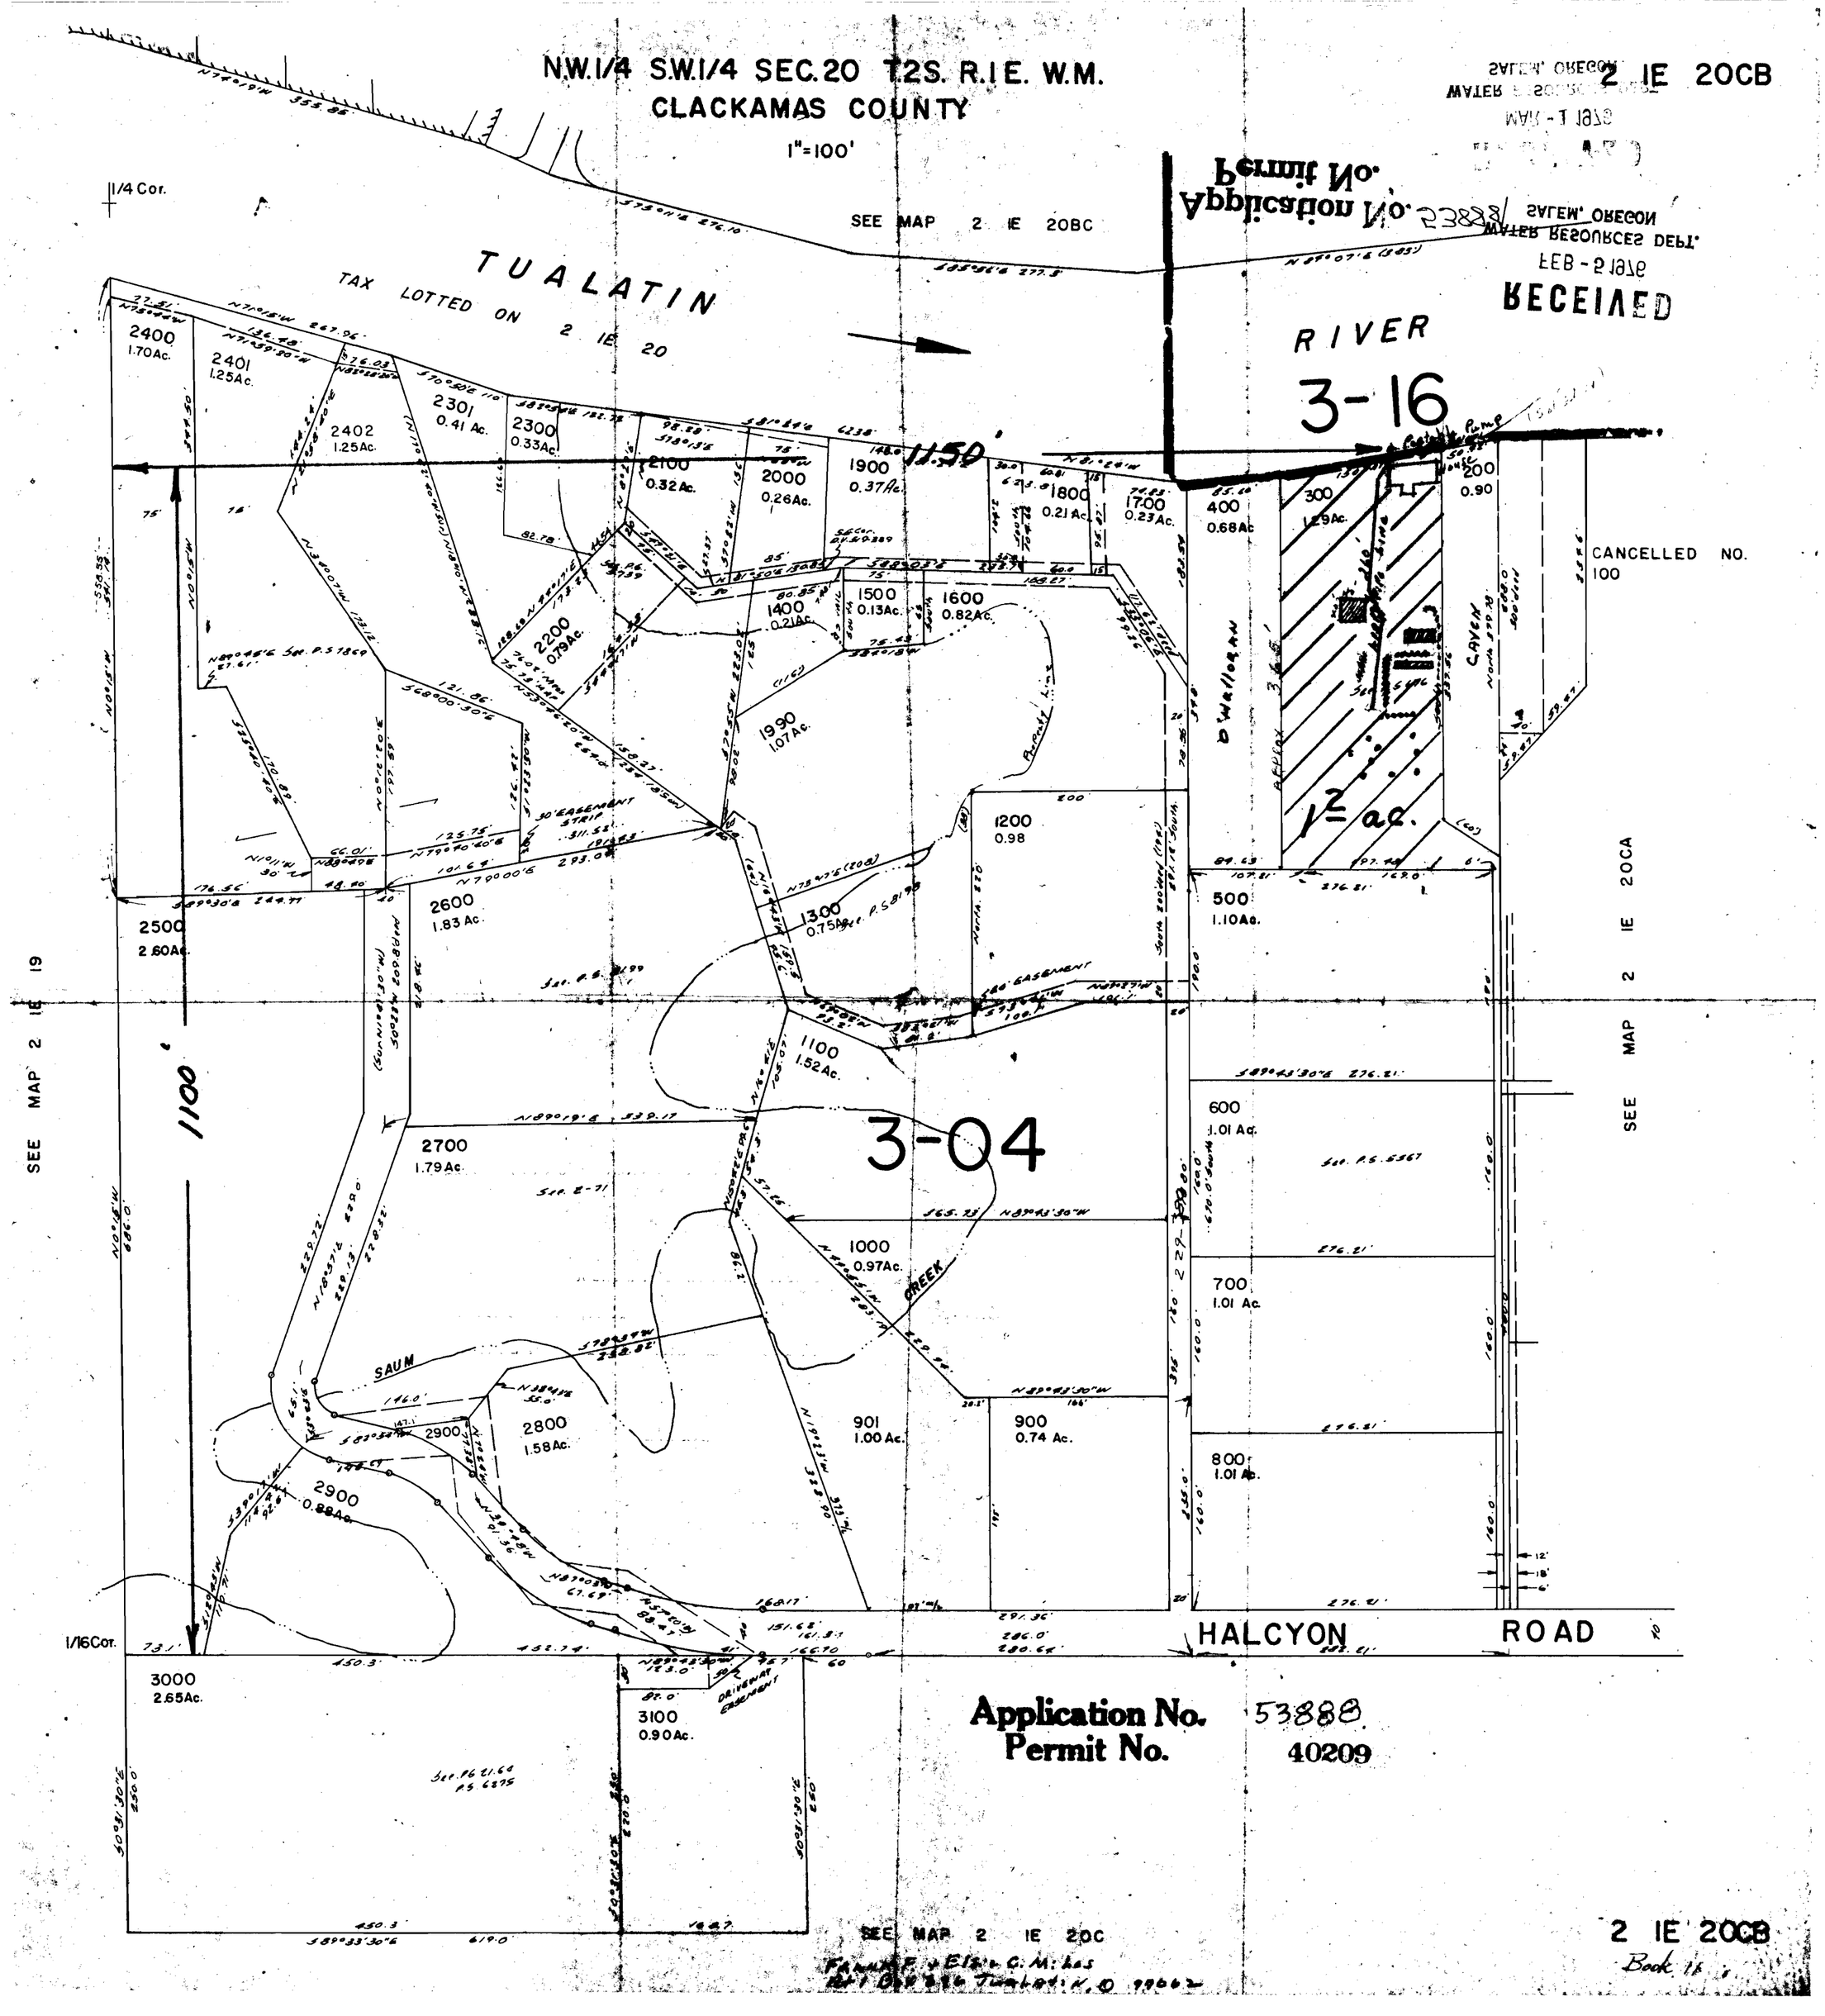

N.W.1/4 S.W.1/4 SEC.20 T.2S. R.1E. W.M.
CLACKAMAS COUNTY
1"=100'
2 1E 20CB
SEE MAP 2 1E 20BC
TUALATIN
TAX LOTTED ON 2 1E 20
RIVER
3-16
3-04
1150'
1100'
1/4 Cor.
1/16 Cor.
CANCELLED NO. 100
SEE MAP 2 1E 19
SEE MAP 2 1E 20CA
SEE MAP 2 1E 20C
HALCYON ROAD
SAUM CREEK
D'Wallorah
Cayen
2400 1.70Ac.
2401 1.25Ac.
2402 1.25Ac.
2301 0.41 Ac.
2300 0.33Ac.
2100 0.32Ac.
2000 0.26Ac.
1900 0.37Ac.
1800 0.21Ac.
1700 0.23Ac.
400 0.68Ac.
300 1.29Ac.
200 0.90
1400 0.21Ac.
1500 0.13Ac.
1600 0.82Ac.
2200 0.79Ac.
1990 1.07Ac.
1200 0.98
1300 0.75Ac.
2600 1.83 Ac.
2500 2.60Ac.
500 1.10Ac.
1100 1.52Ac.
2700 1.79Ac.
600 1.01 Ac.
1000 0.97Ac.
700 1.01 Ac.
2900
2800 1.58Ac.
901 1.00 Ac.
900 0.74 Ac.
800 1.01 Ac.
2900 0.88Ac.
3000 2.65Ac.
3100 0.90Ac.
Application No. 53888
Permit No. 40209