


1" = 200'

NW 1/4 NE 1/4  
Sec 12 T. 27 S.  
R. 2 W. W.M.

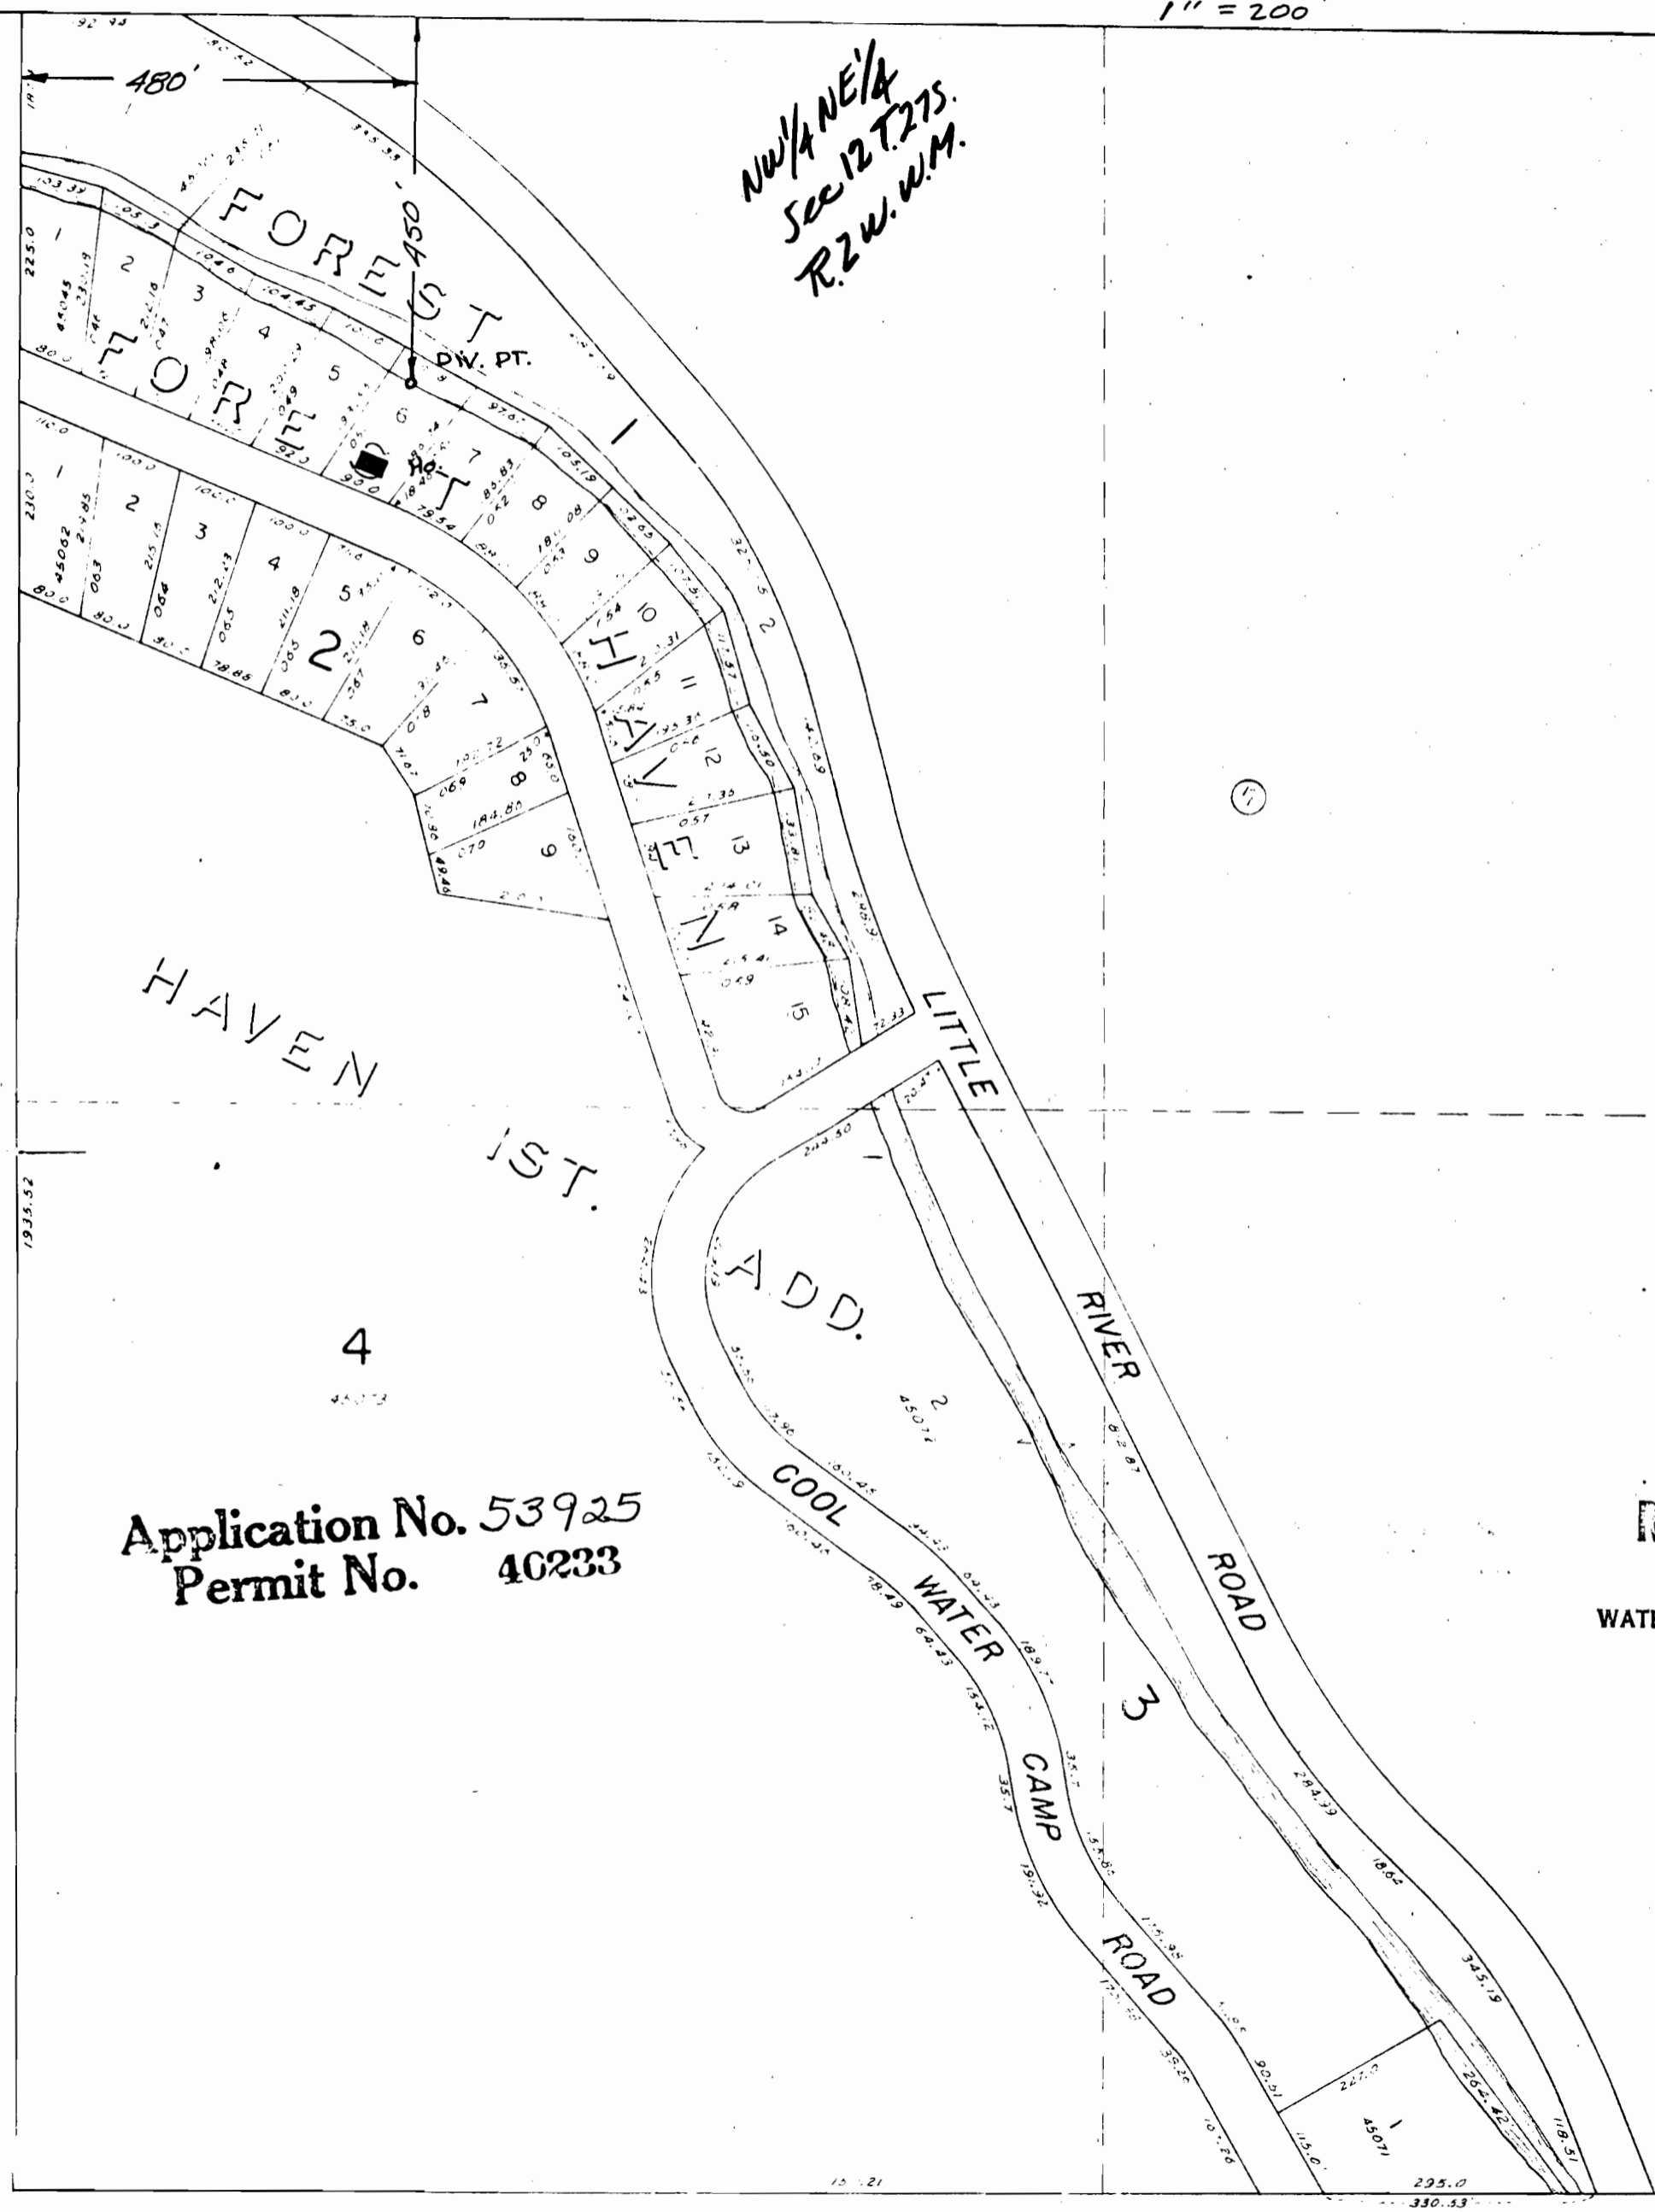

Application No. 53925  
Permit No. 40233

**RECEIVED**  
FEB 19 1976  
WATER RESOURCES DEPT.  
SALEM, OREGON