


SECTION 20 T. 18S R. 11 W W M
1" = 400'

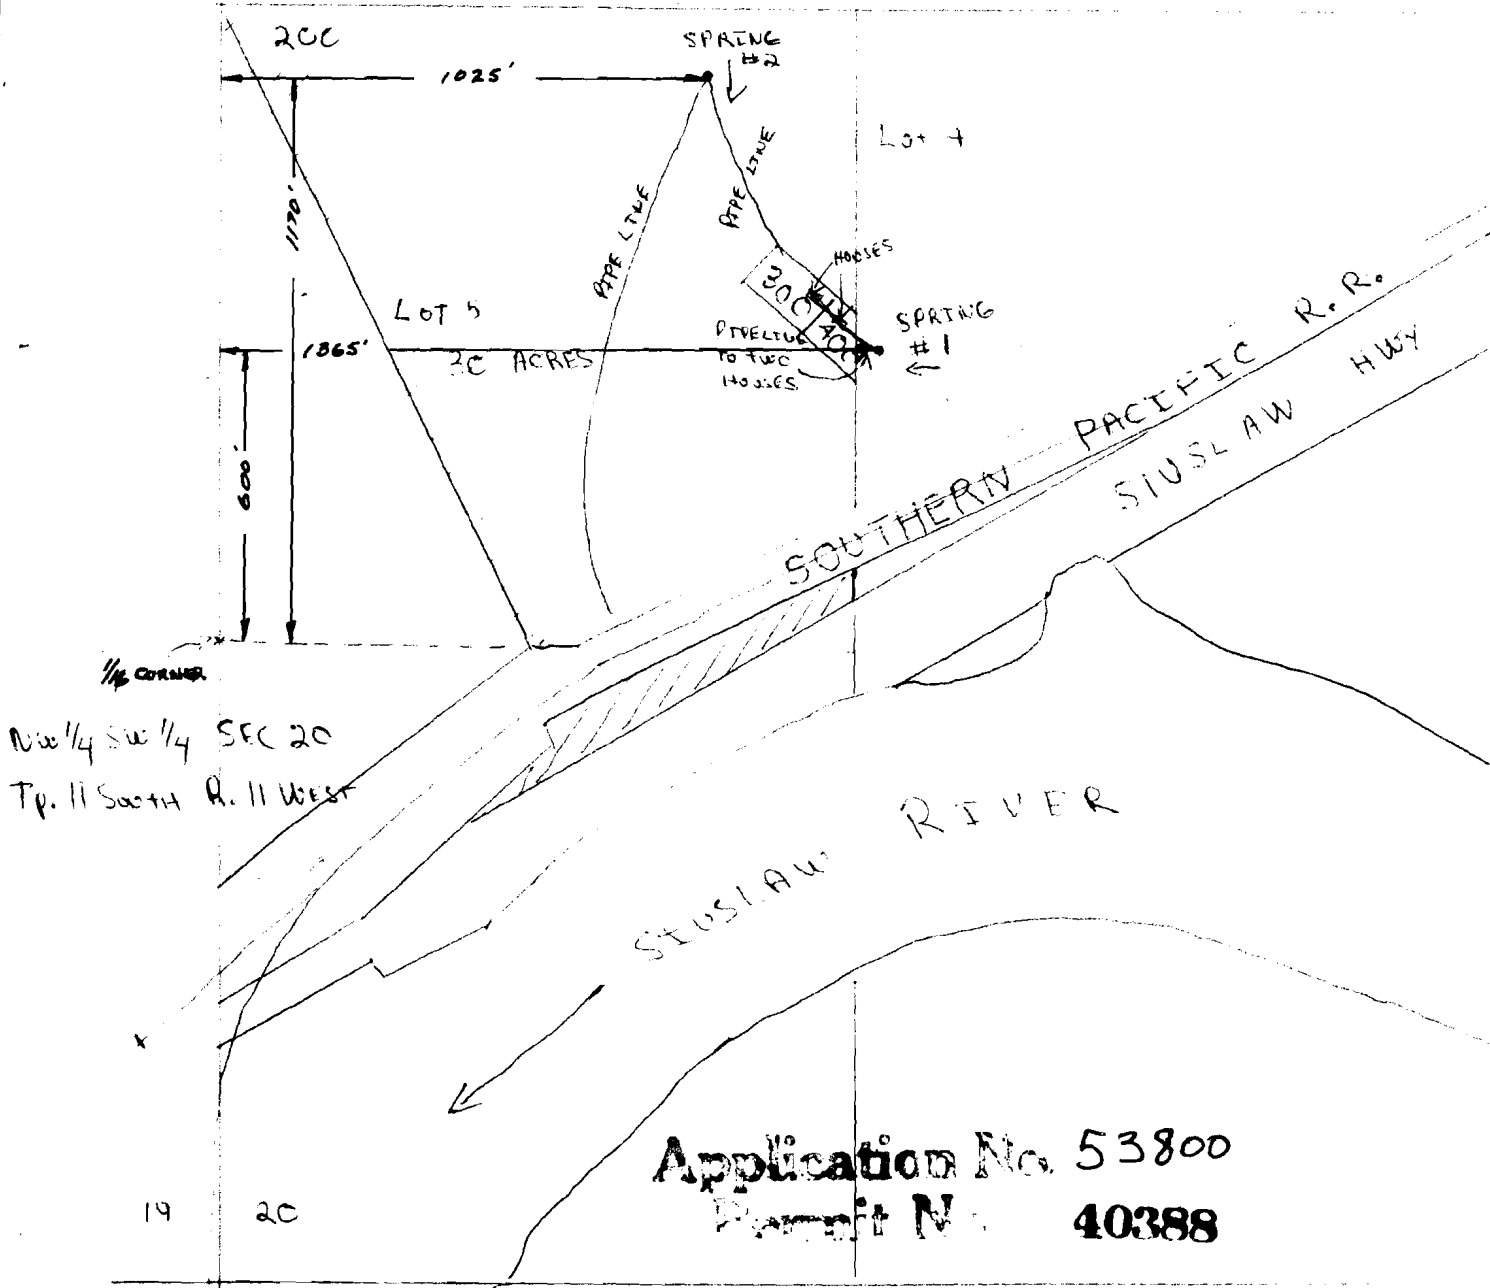

Application No. 53800
Permit No. 40388

19 20
30 29

Application No.
Permit No.

RECEIVED
DEC 12 1975
WATER RESOURCES DEPT.
SALEM, OREGON