


MAP

Accompanying application of Mrs E. E. LEHRMANN of Grants Pass, Josephine County, Oregon. for permit to the Waters of Little Savage Creek, tributary to Rogue River. Jackson County. Oregon.

March 10th 1919.

Tp 36. S. R. 4. W. W. M.

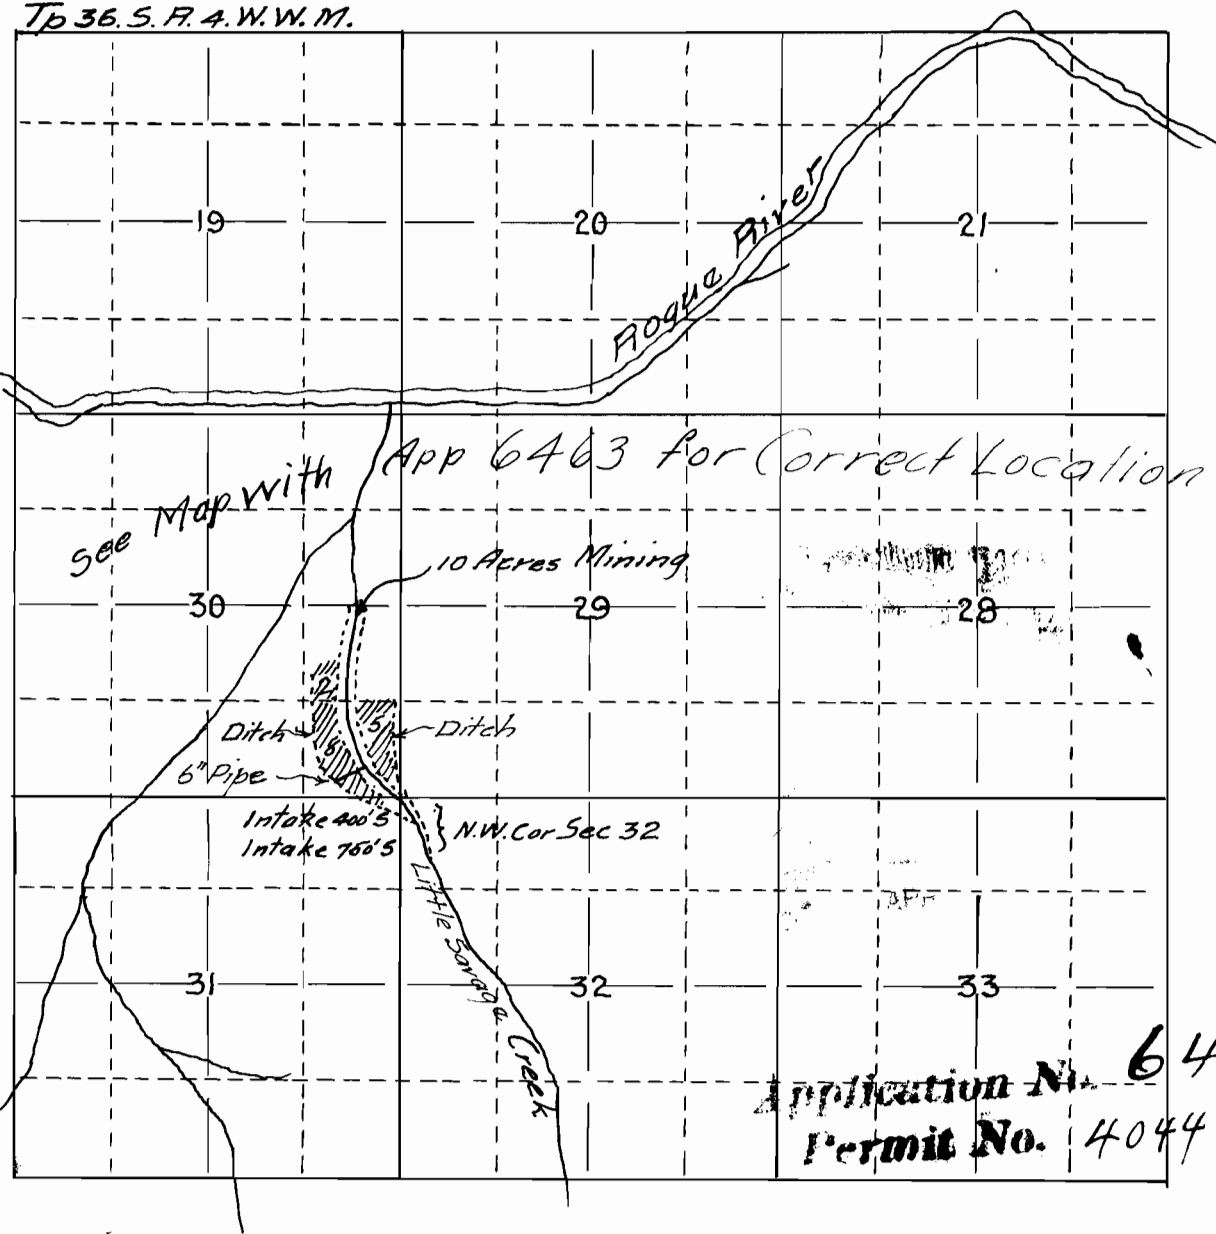

Application No. **6464**
Permit No. **4044**

Map made from notes and measurements by E. E. Lehrmann of his property. inspected in the field by myself and same correctly shows the lands to be mined, together with the streams and ditches in the immediate vicinity.

Fred. N. Cummings. C.E.
Medford. Ore.