


T.38 S., R.5 W., W.M.

RECEIVED
JUN 16 1982
WM. DIST. 14
GRANTS PASS, ORE.

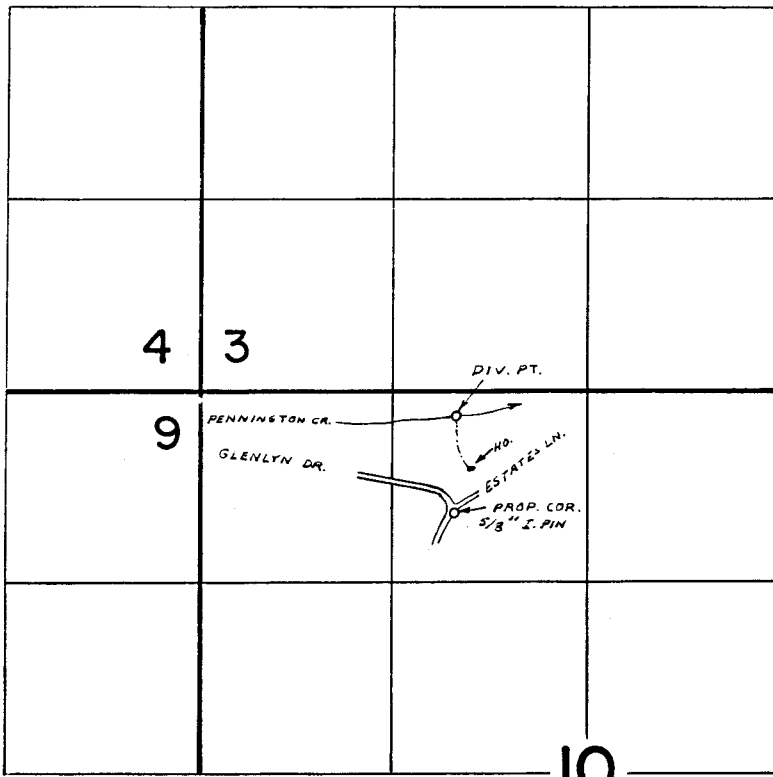

DIV. PT. LOC.: 170' S. & 890' W. FROM N 1/4 COR. SEC. 10

FINAL PROOF SURVEY
UNDER

Application No. 51646 Permit No. 40445
IN NAME OF

Arthur & Georgia Jones

Surveyed OCT. 18 1978, by B. SUND

P.T.S. - 1978 - 14 - D