


50 acres

T. 33S - R. 10W - S. 10
BLM.

North Line
Section 10

Brass Cap
N 56° 10' 10"
56' 1980'

Site (A) (North of Marial Rd.)

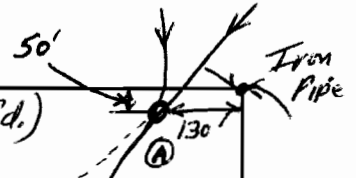

Homesite (A)

NW 1/4 of
NE 1/4

BLM

Site (B) (South of Marial Rd.)

NE 1/4 of
NW 1/4

Marial Rd.

VENNER CREEK

Private Drive

660'

BLM

1320'

--- = Pipeline
O = Pt. of diversion

To Marial

650'

(B)

Homesite (B)

Unnamed Creek

410'

660'

Iron Pipe



1320'

Brass Cap

Private Property

N-S
Centerline
Sec. 10

Scale - 1" = 300'

Application No. 54074
Permit No. 40489