


T. 27 S. R. 2 W. N.E. SEC. 12

1
12

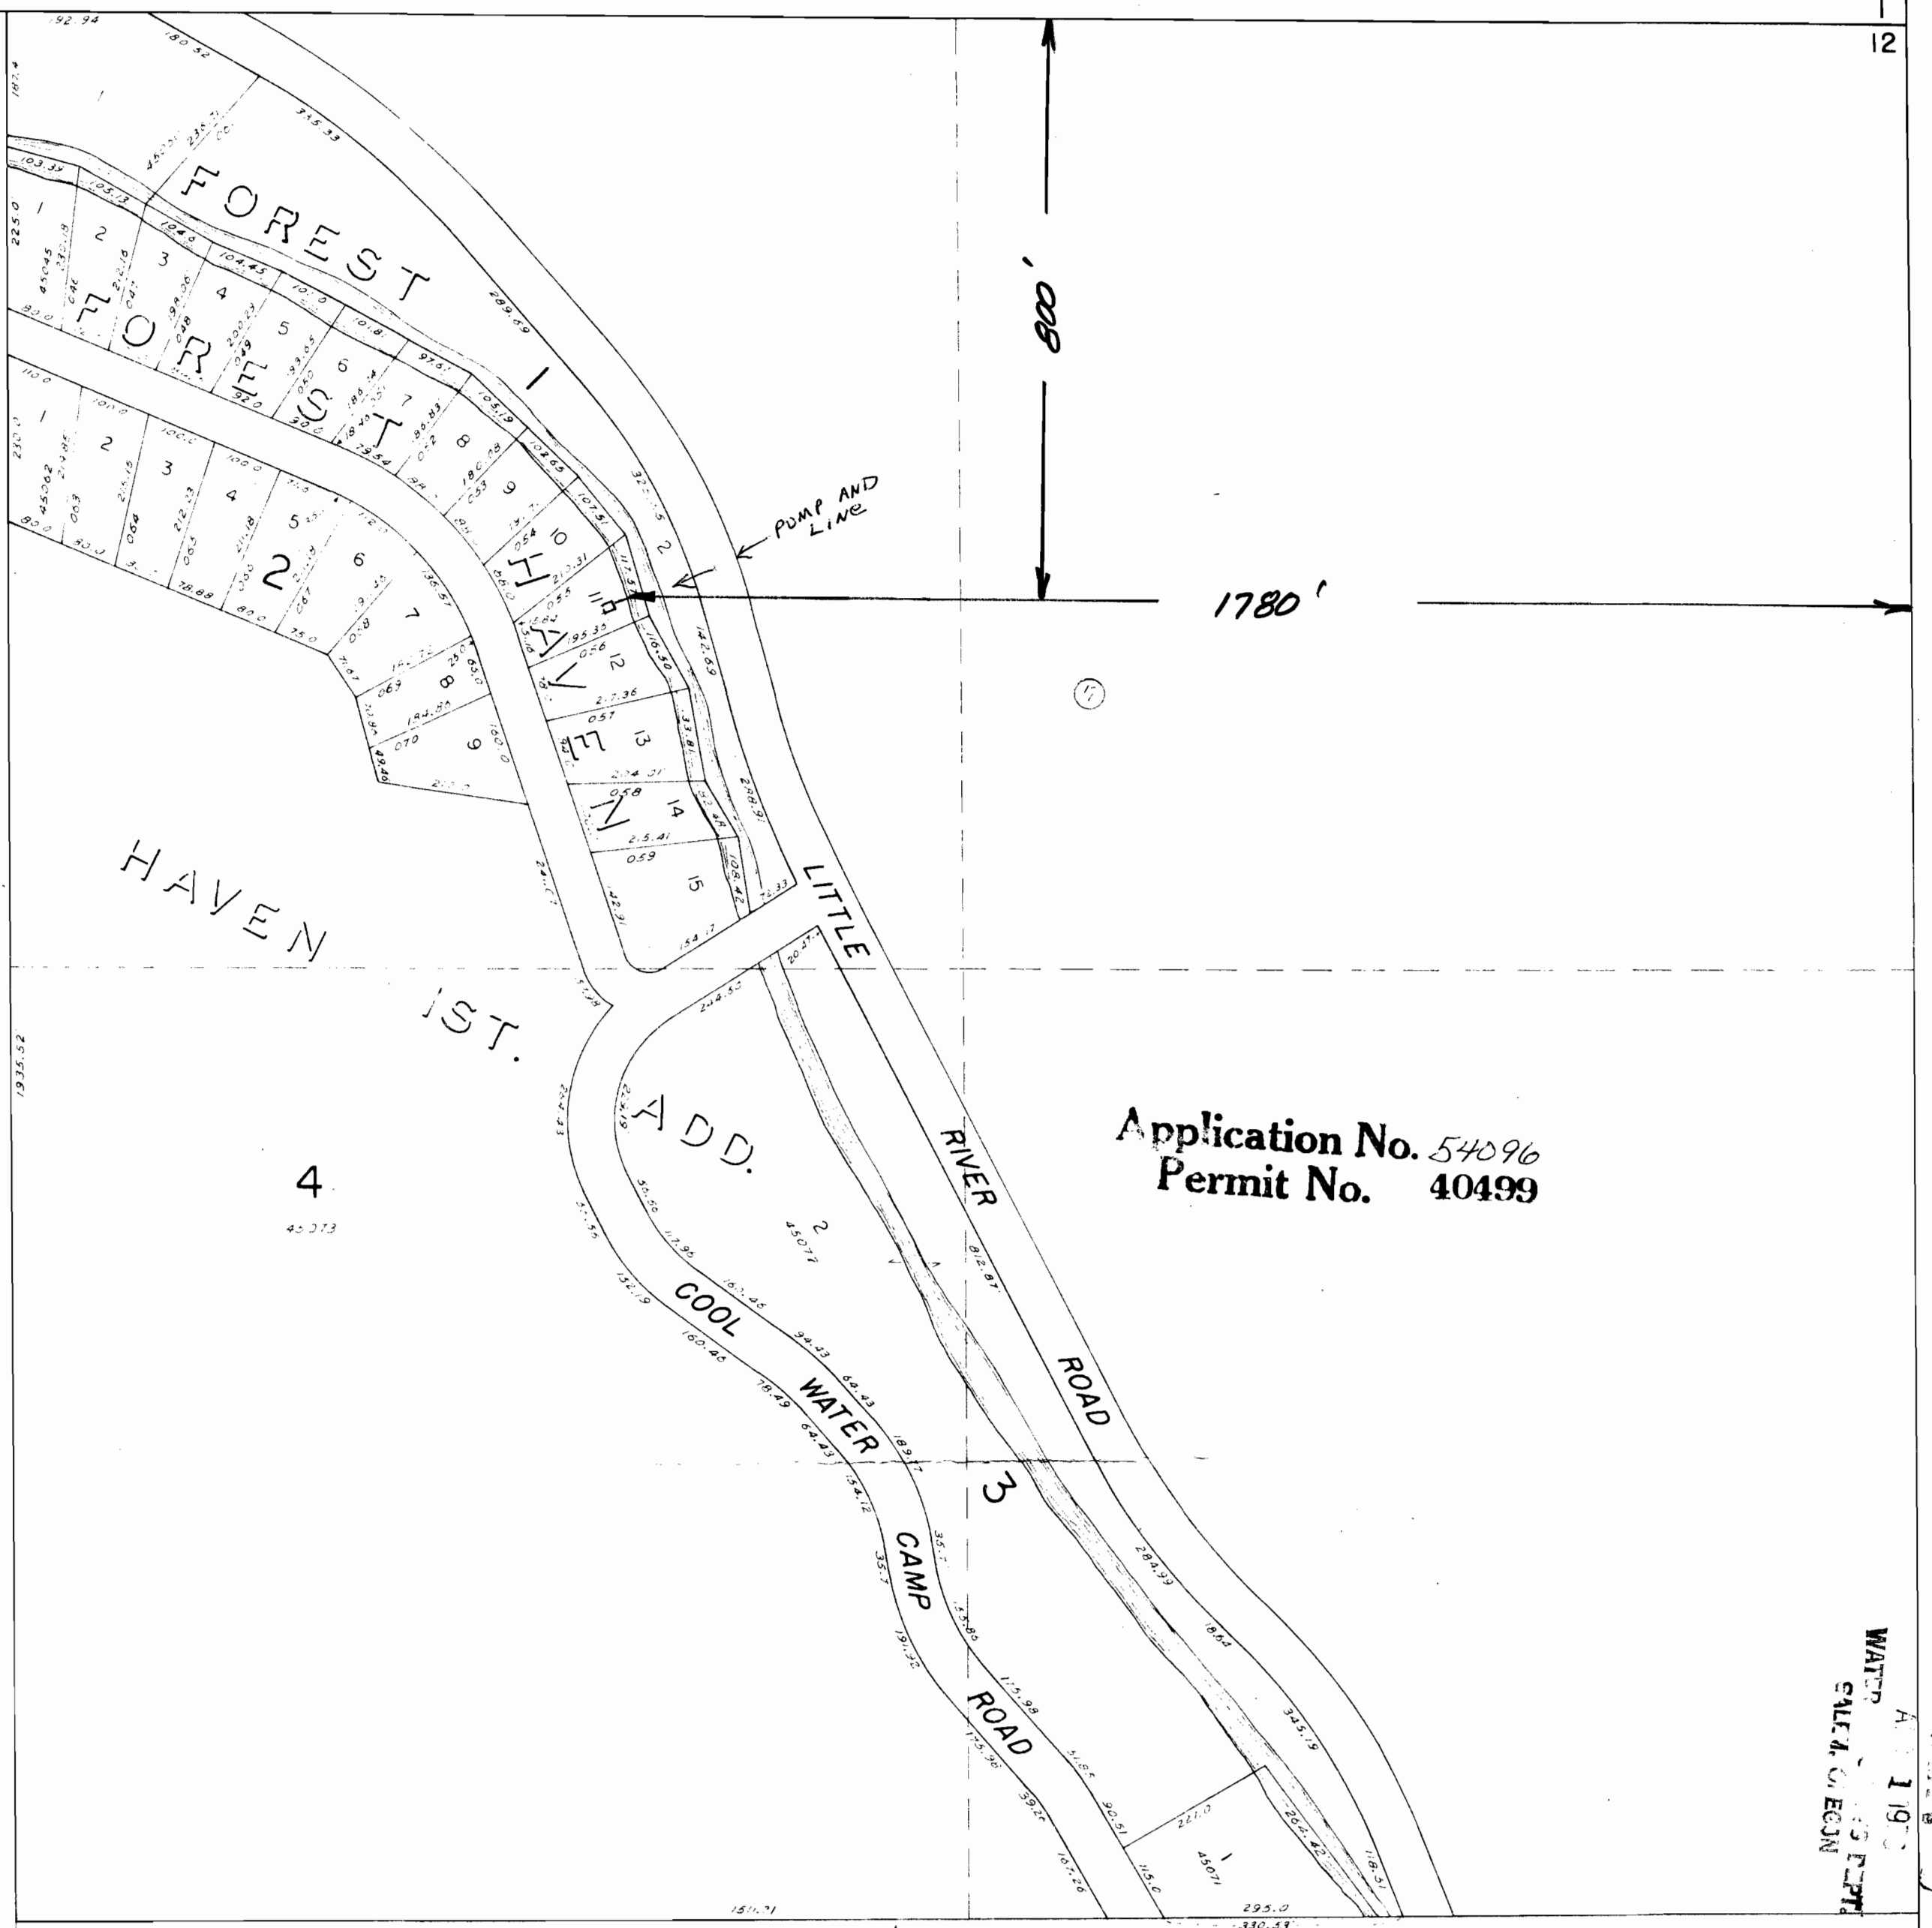

Application No. 54096
Permit No. 40499

WATER
SALE A. OF ECON
AUG 1 1973