


T. 26 S. R. 4 W. Pt. N.W. SEC 19

1" = 200'

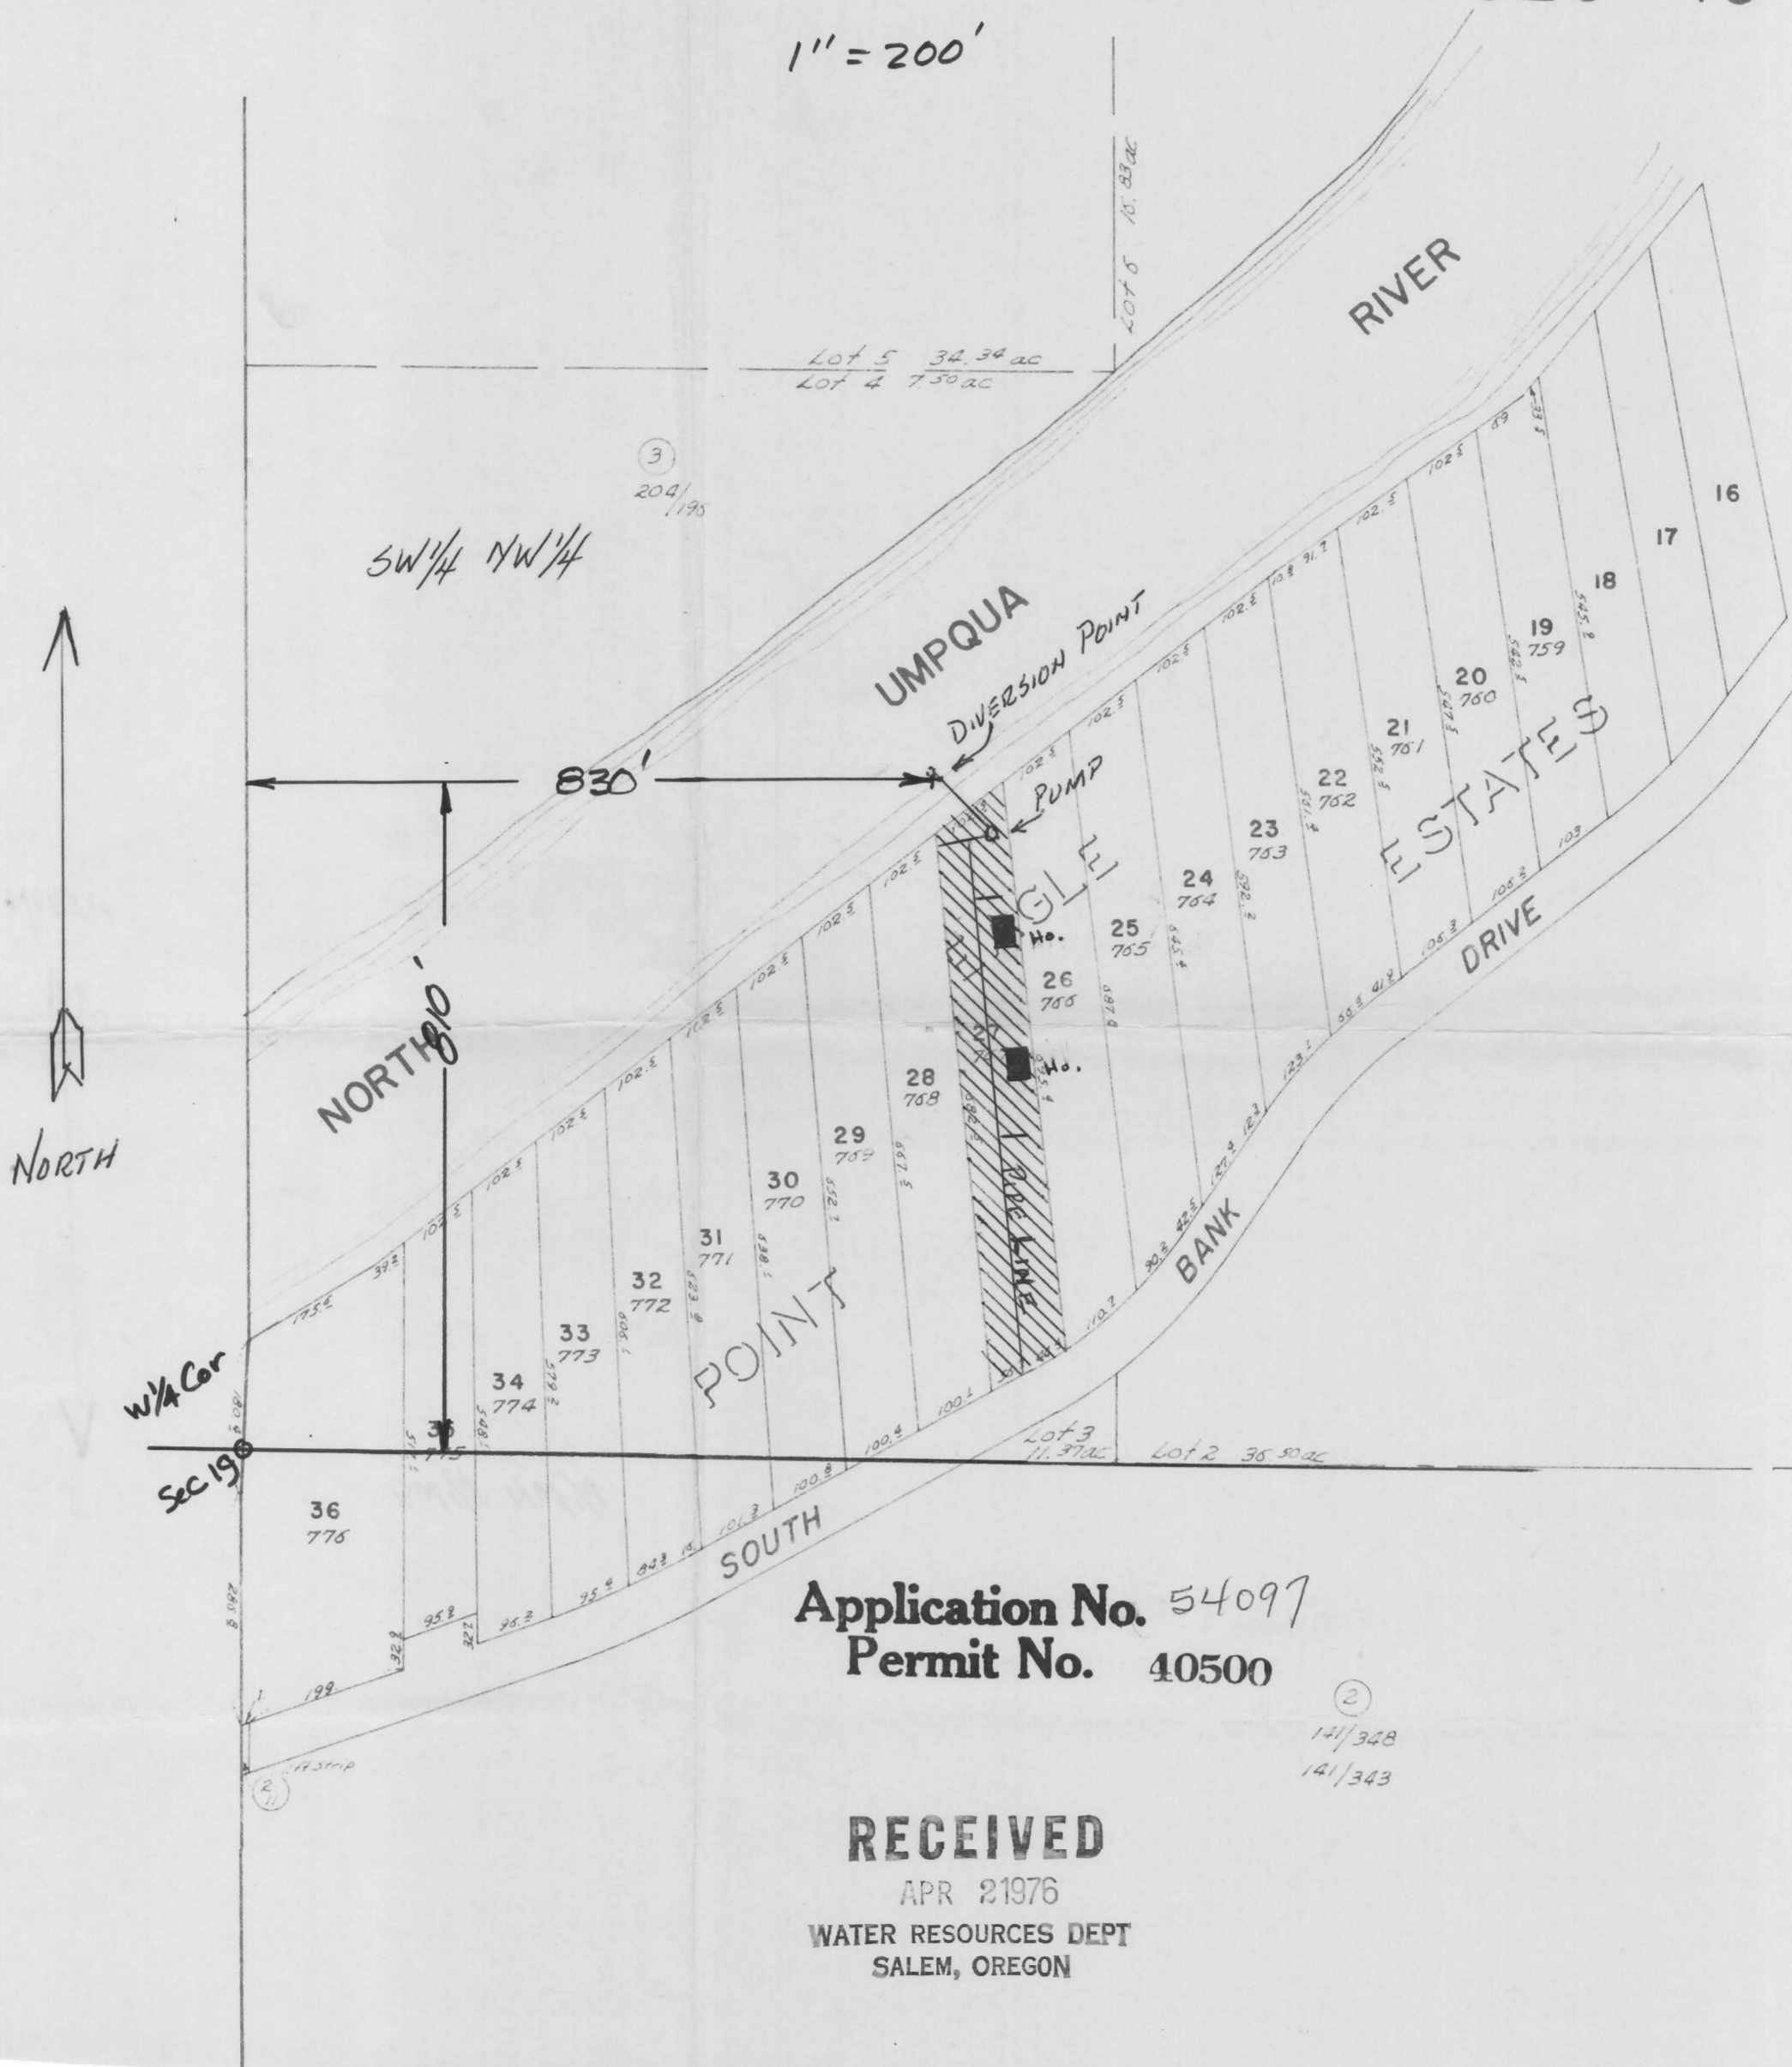

Application No. 54097
Permit No. 40500

RECEIVED

APR 21976

WATER RESOURCES DEPT.
SALEM, OREGON



