


John W. Walker
D.L.C. No 49

6233

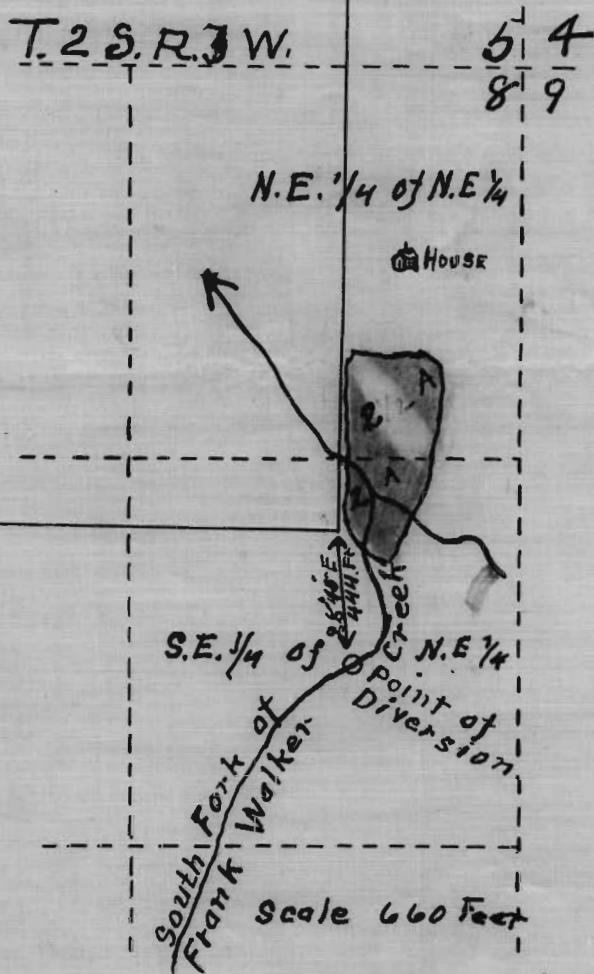

I, A. A. Morrill, of Hillsboro, Oregon, do hereby certify that this map was made from notes taken during an actual survey made by me on July 21st. 1918. that it correctly represents the works described in the accompanying application, together with the location of streams and other ditches in the immediate vicinity, and has written thereon the area in each smallest legal subdivision which it is proposed to irrigate.

A. A. Morrill
surveyor

Application No. 6233
Permit No. 4055

OFFICE OF STATE ENGINEER
RECEIVED
AUG 8 1918
SALEM, OREGON

6233