


Application No. R-54263 + 54264
Permit No. R 6478 & 40592

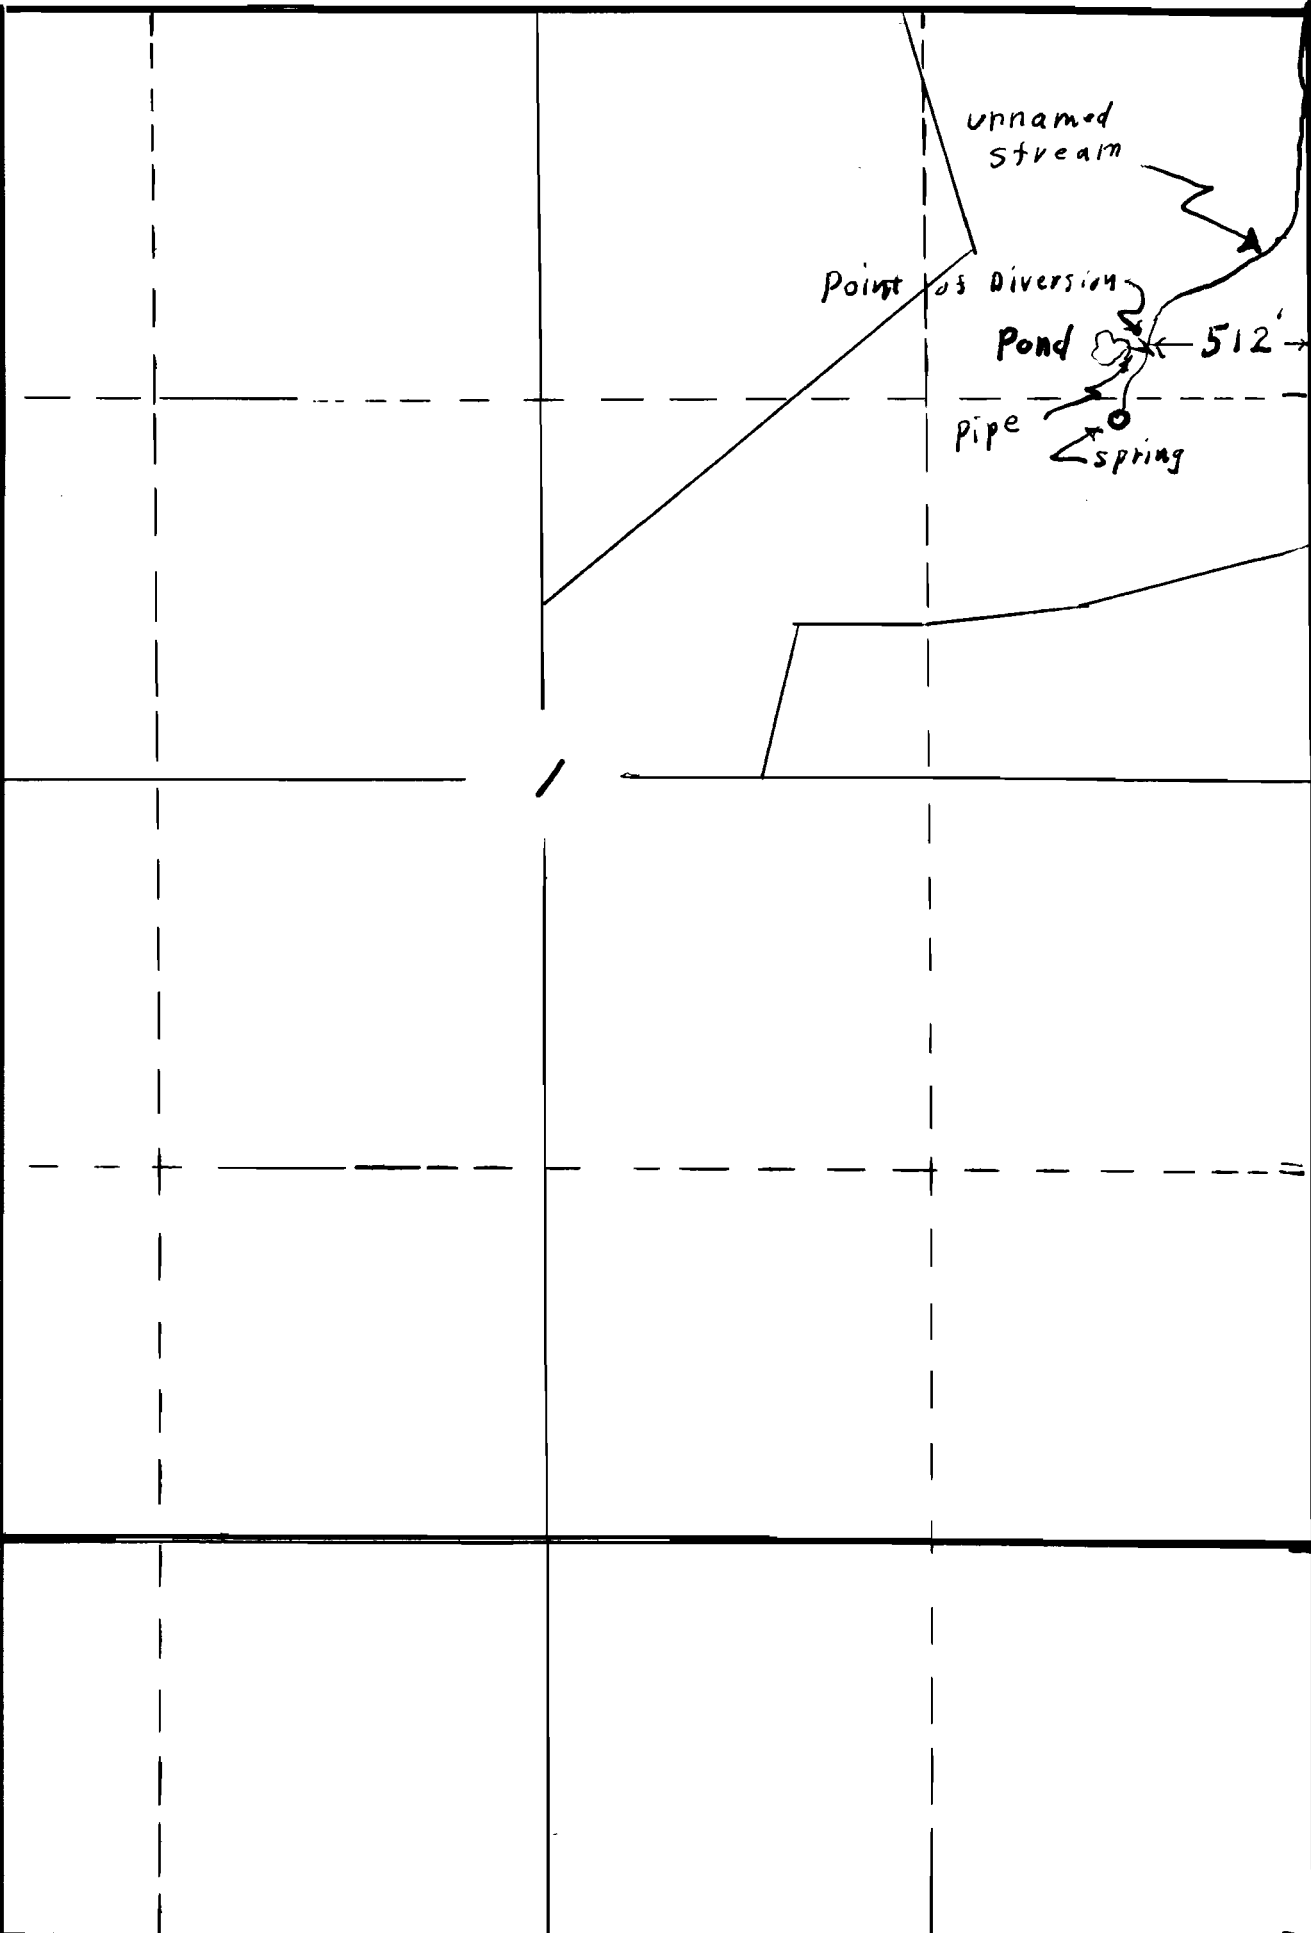

Sec I

TP 6S

R4W

Scale =
8" = 1 Mile

RECEIVED
13 1976
WATER RESOURCES DEPT

11