


Range 26 E.

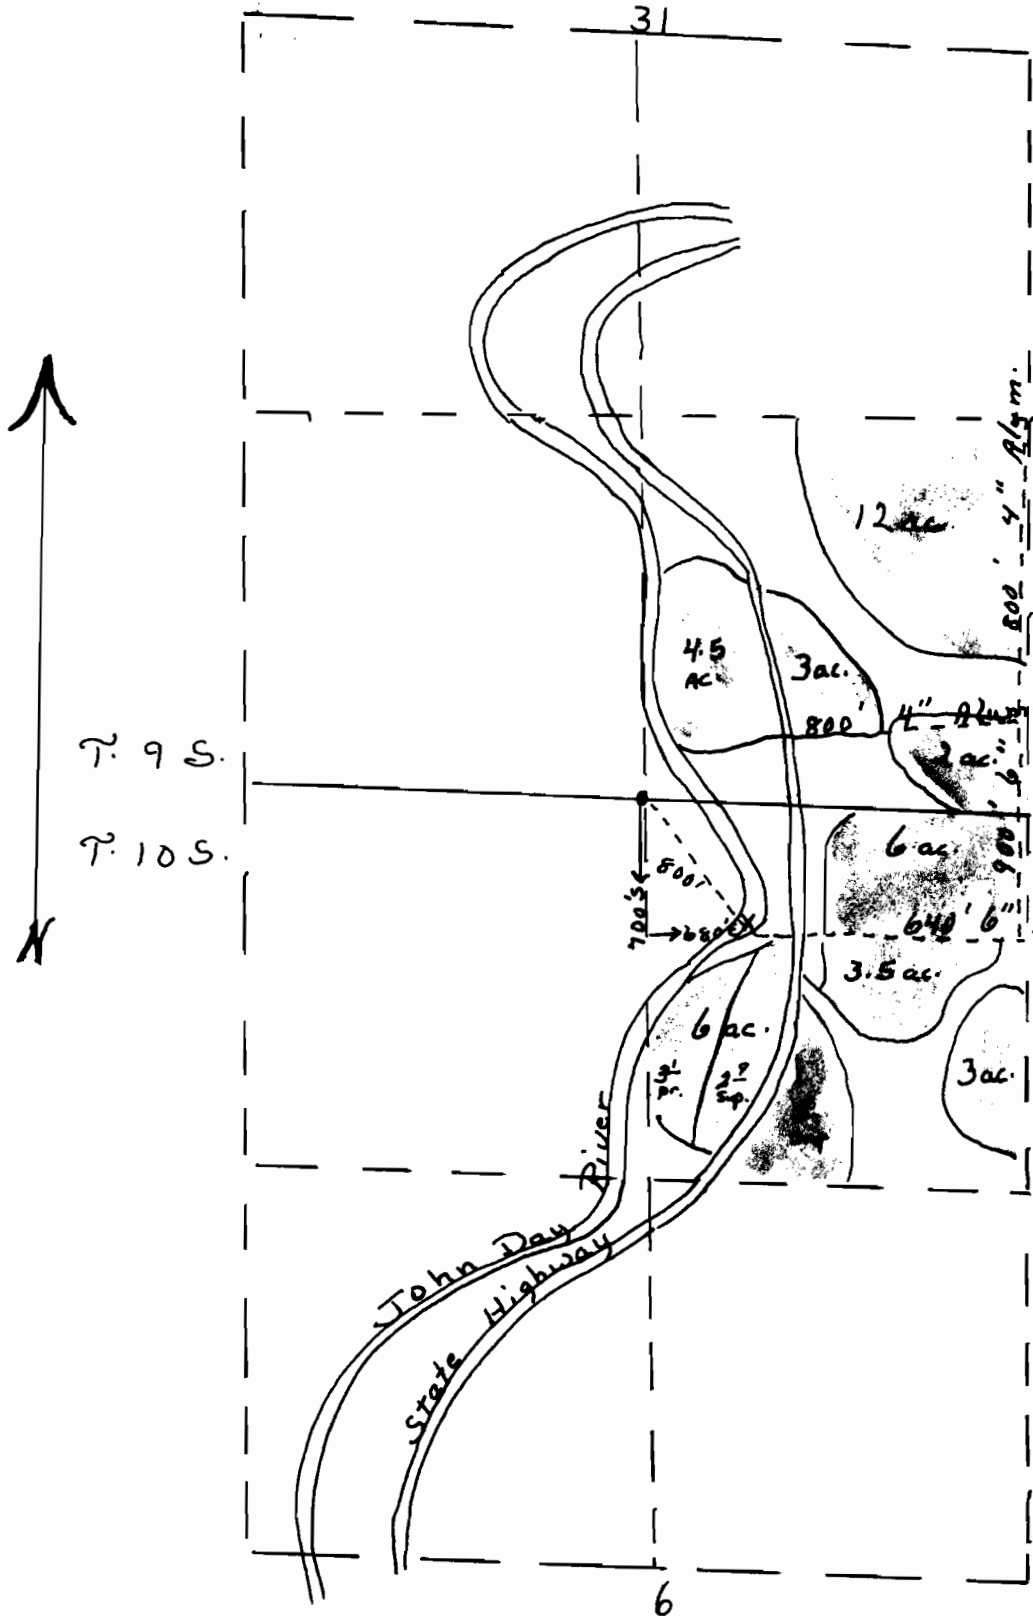

21.5
~~18.5~~ ac.
 NW 1/4 NE 1/4 Sec. 6
 21.5 ac.
 SW 1/4 SE 1/4 Sec. 31

Scale: 8" = 1 mile

Application No. 53936

Permit No. 40002