


Sec. 6  
Sec. 7  
NE 1/4 NW 1/4

2.7 A

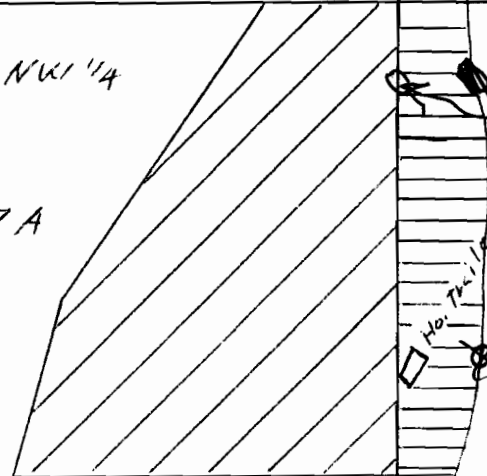

NW 1/4 NE 1/4

1.0 A

Kray Creek

Application No. 54239  
Permit No. 40627

P.O.D. located 360' S. & 85' E. from the  
N. 1/4 corner of Section 7

N. 1/4 corner  
Sec 7  
IP set  
BT. 4" S. 14" maple  
292.11' from N. 1/4 corner  
3130.8' from E. section  
N 29° W  
S 15° W  
29-1  
18-1

RECEIVED  
MAY 10 1976  
WATER RESOURCES DEPT  
SALEM, OREGON

T. 29 S. R. 6 W. W. M.  
Scale 1" = 200'