



N^{1/2} Sec 4, Township 2 North, Range 105 West
 Hood River County, Oregon

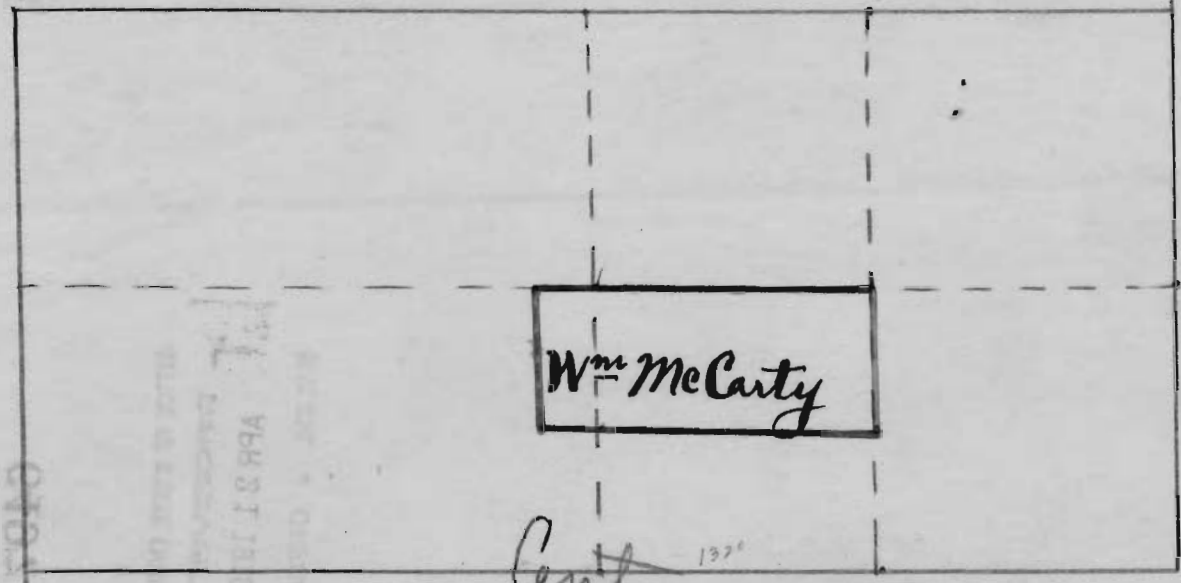

Center
 Sec 4
 S

Application No. 6497
 Permit No. 4065

OFFICE OF STATE ENGINEER
 RECEIVED
 APR 21 1919

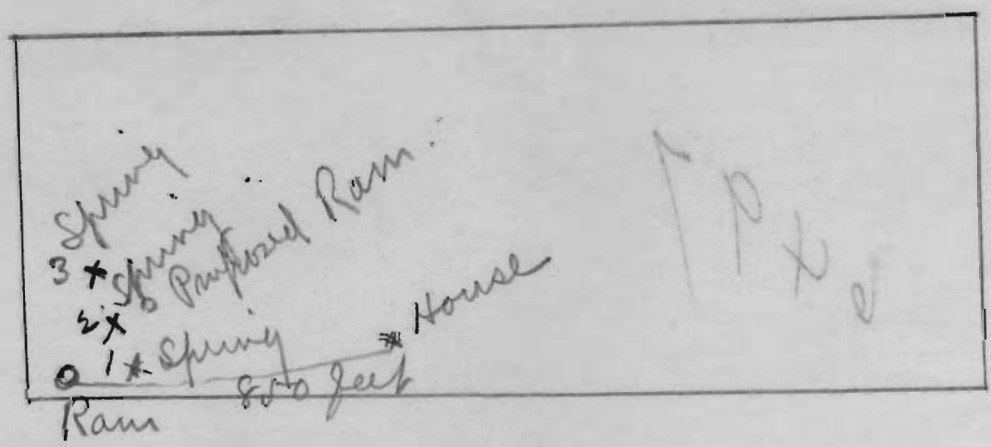

- 1 X = 50 feet from S line + 150 feet from W. line
- 2 X = 150 feet from S line + 100 feet from W. line
- 3 X = 200 feet from S line + 75 feet from W. line