


Application No. 54301
Permit No. 10660

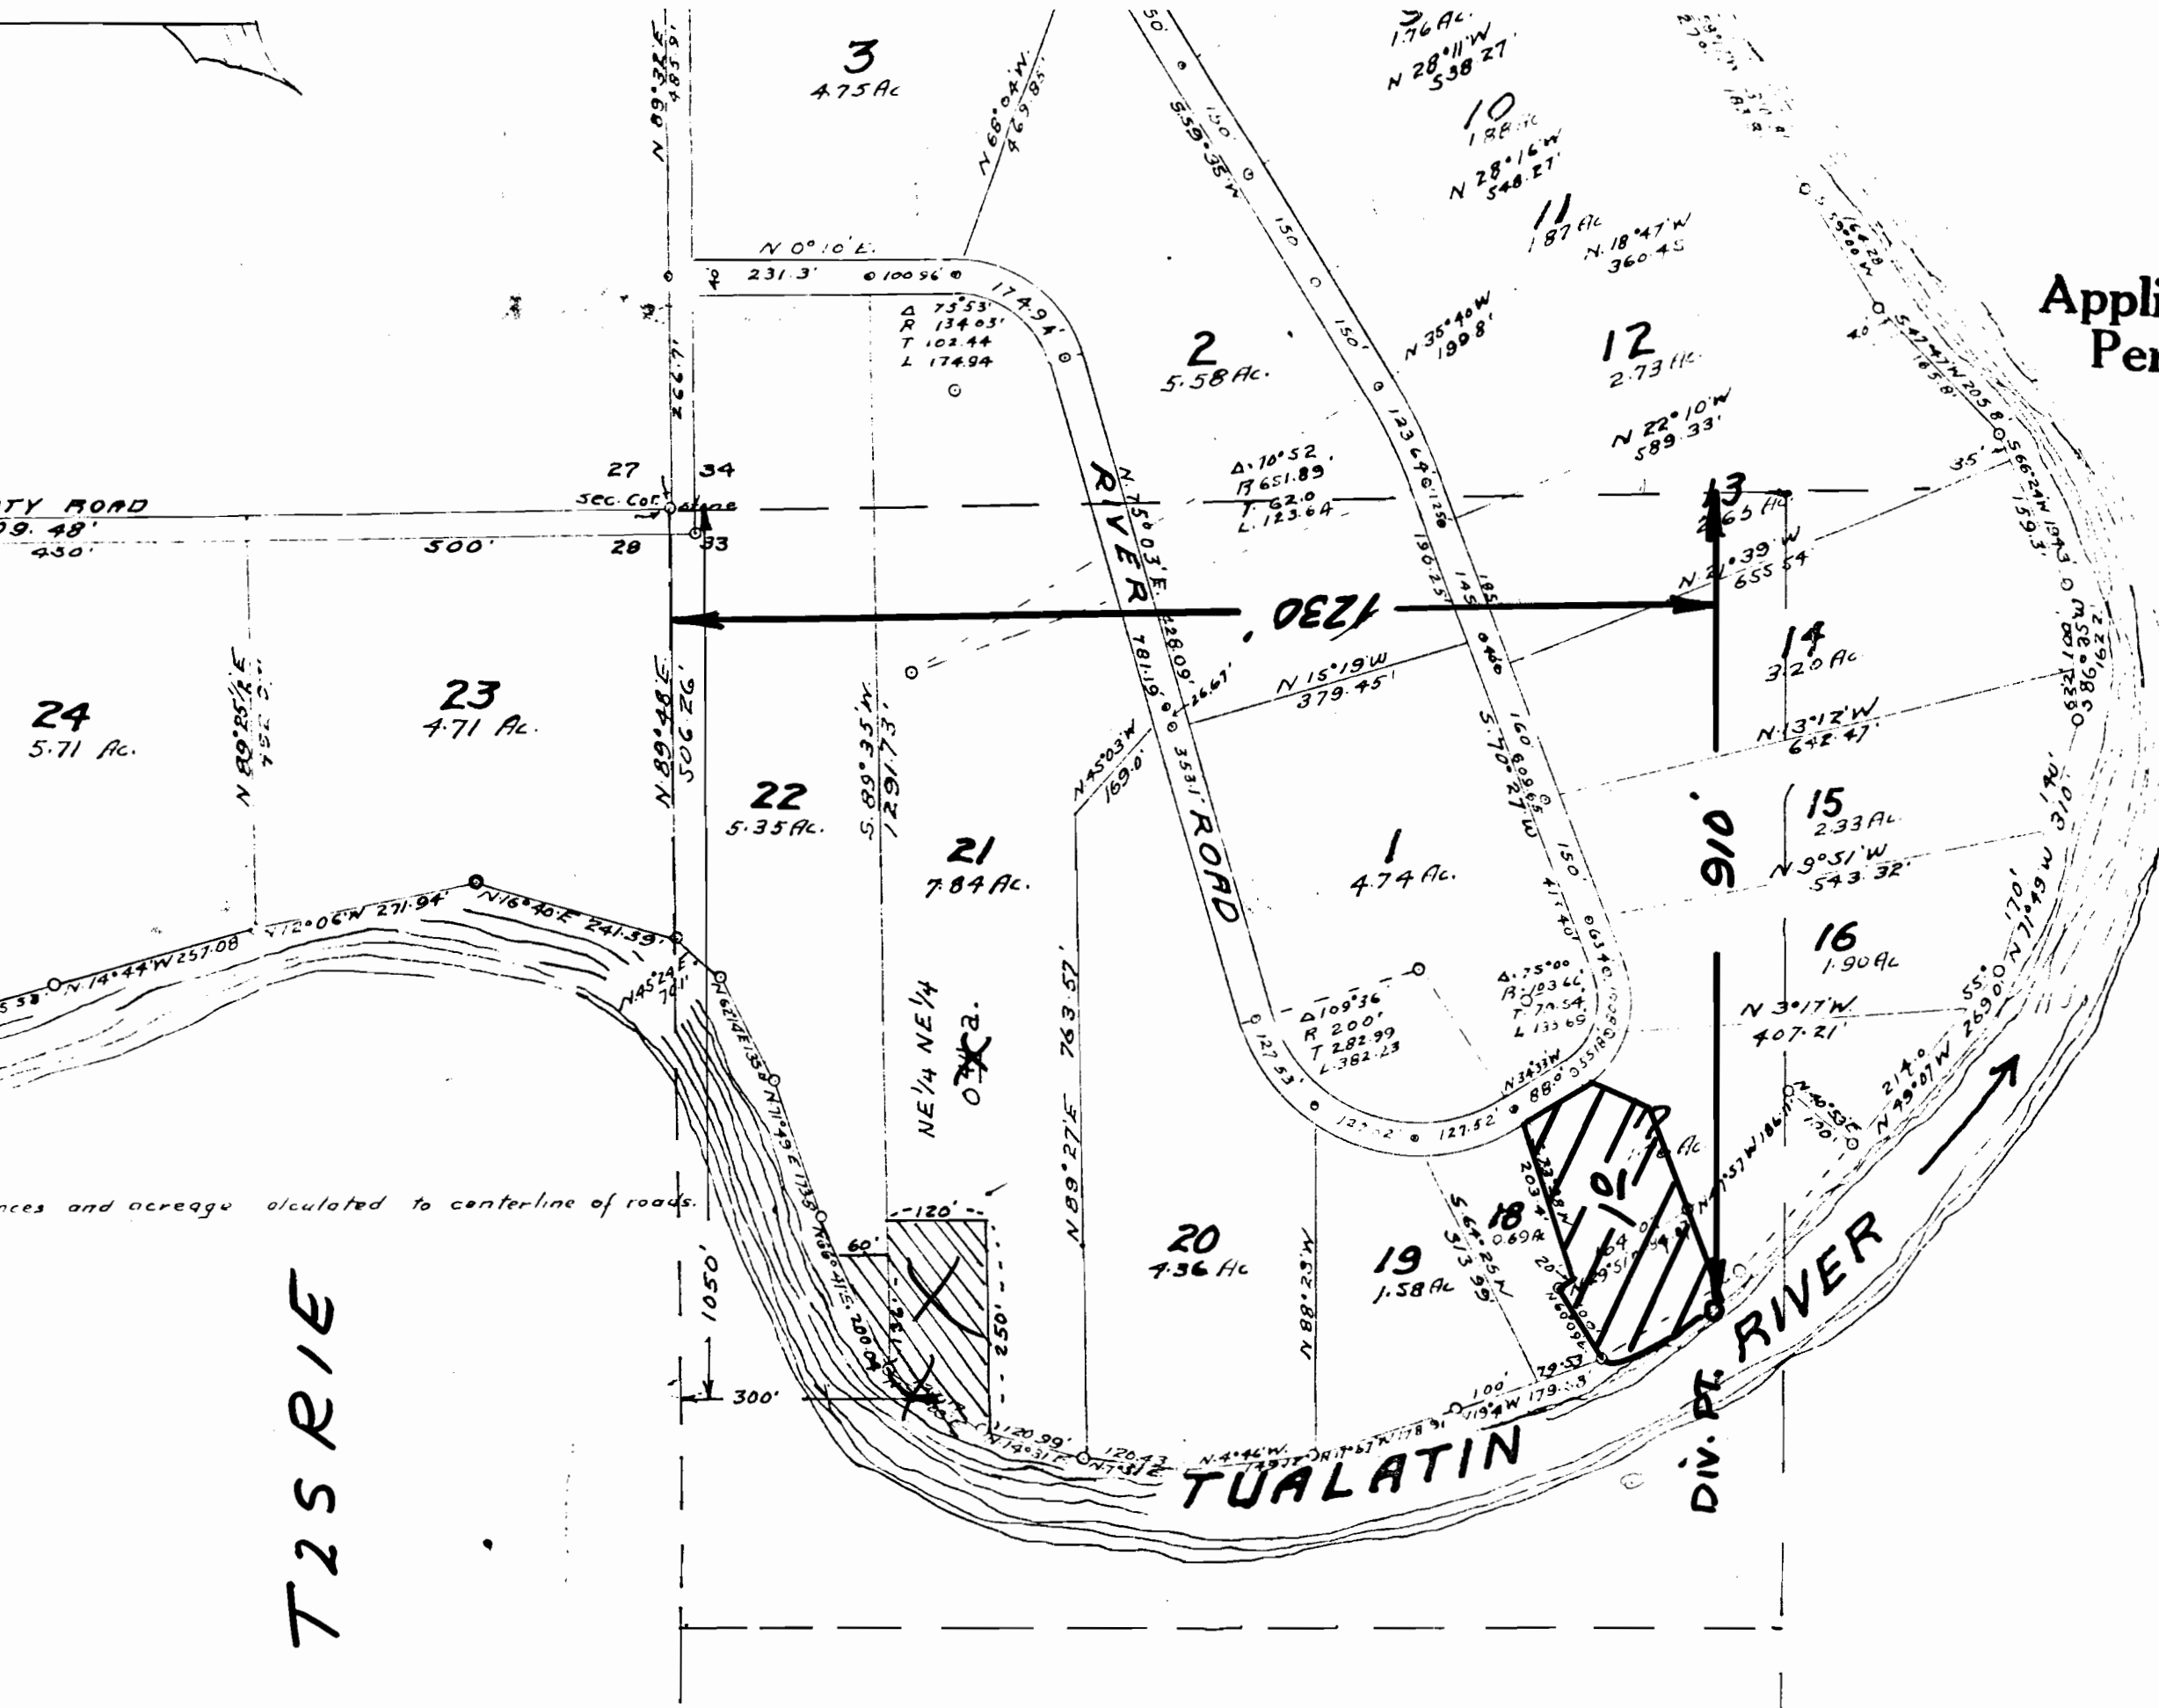

T2S R1E

