



T. 24 S., R. 7 W., Sec. 29

SE 1/4 NW 1/4

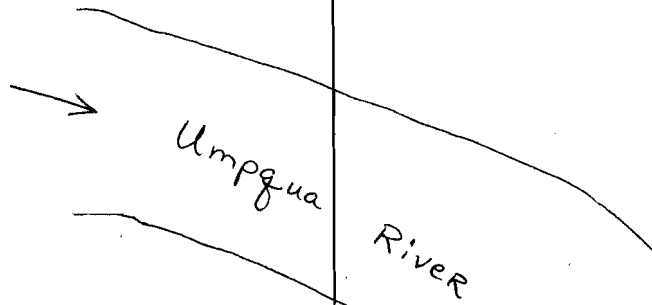


1" = 400'

3,030' N.
1,620' E

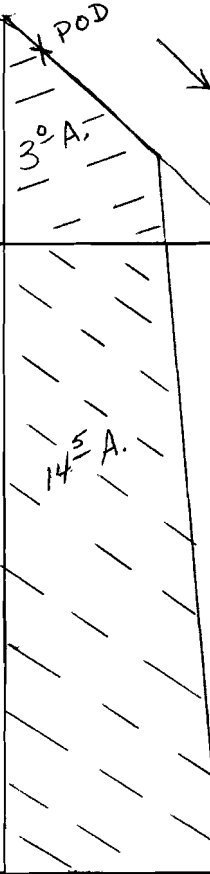

NE 1/4 SW 1/4

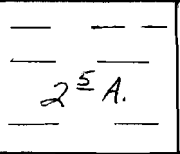

Application No. 54328
Permit No. 40674

RECEIVED

JUN - 8 1976

WATER RESOURCES DEPT
SALEM, OREGON

30 29

31 32

SE 1/4 SW 1/4