


T. 34 S., R. 8 W., W.M.

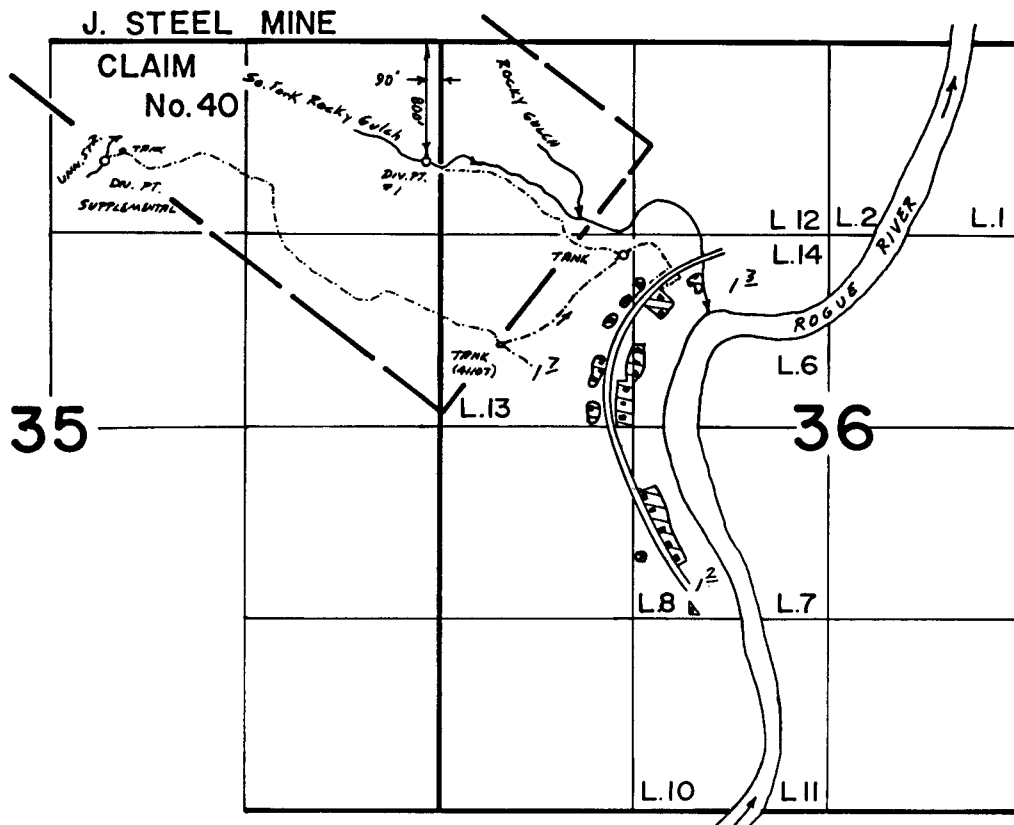

■ = HOUSE

Scale 1"=1320'

FINAL PROOF SURVEY UNDER

Application No. 54333.. Permit No. 40733...
IN NAME OF

GALICE.....SUBDIVISION WATER CO.

Surveyed JUNE 21 1984, by BS JAMES.....

RECEIVED

DEC 17 1986

WM. DIST. 14
GRANT PASS, ORE.

41033-179-2044

bsj