


T. 36 S., R. 5 W., W.M.

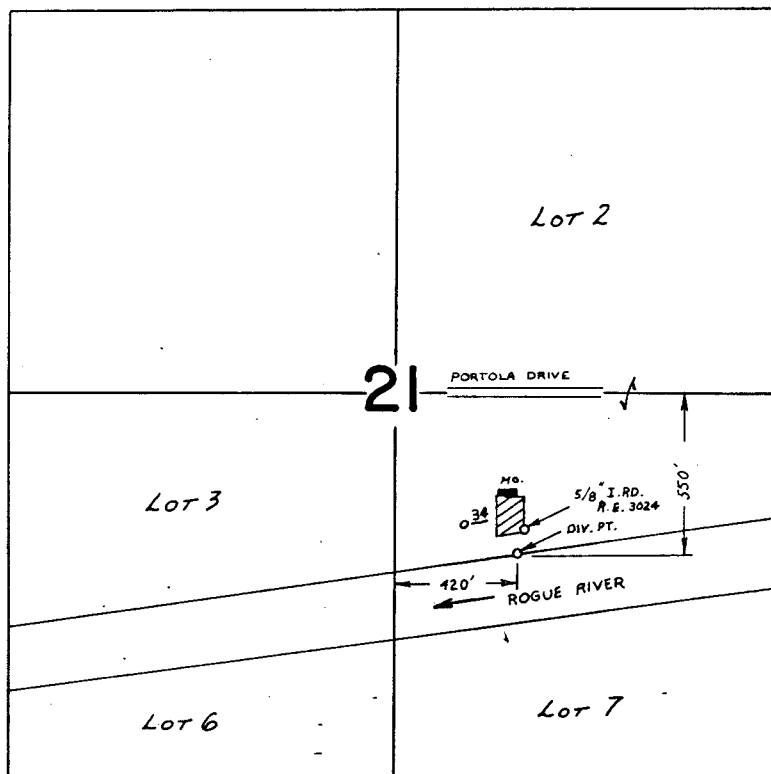

SCALE: 1" = 660 FT.

FINAL PROOF SURVEY
UNDER

Application No. 54374 Permit No. 40751
IN NAME OF

ALFRED C. BRITTAIN

Surveyed JUN. 22 1978, by B. SUND

P.T.S. - 1978-14-A

RECEIVED
OCT 1 1981

WM. DIST. 14
GRANTS PASS, ORE