


T. 37S., R. 8W., W.M.

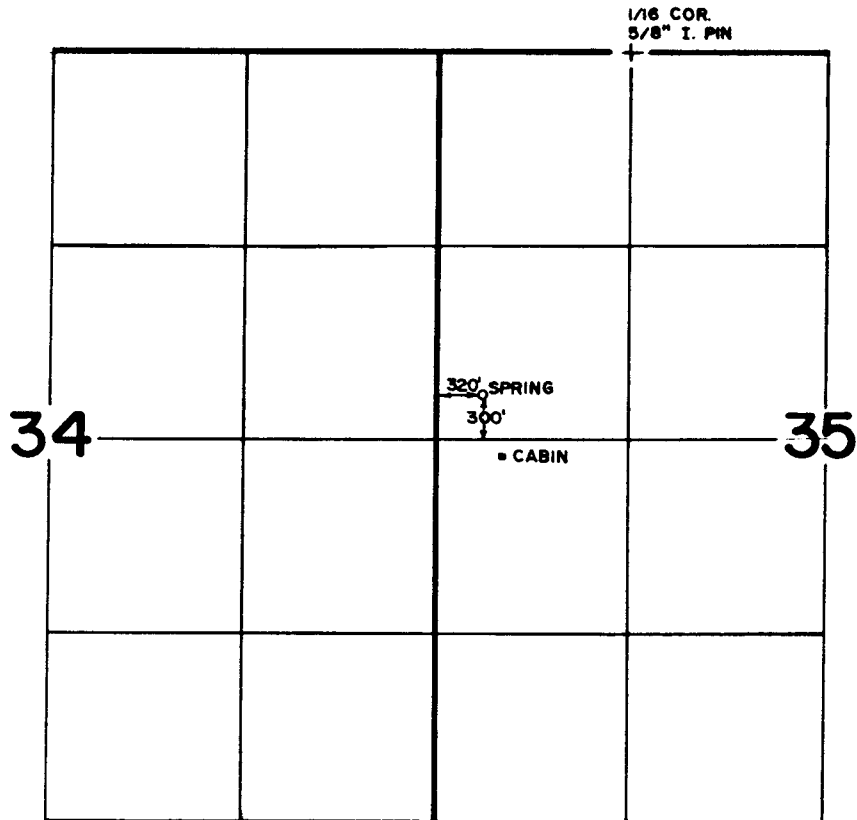

MAR 30 1988

COPY TO
CITY OF

FINAL PROOF SURVEY
UNDER

Application No. 54307 Permit No. 40774
IN NAME OF

J. THOMAS & BARBARA C. STROUT

Surveyed OCT. 26, 1983, by B. S. JAMES

SCALE: 4" = 1 MILE

179-195L

TWB