
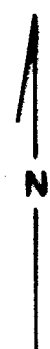


T. 37 S., R. 7 & 8 W., W. M.

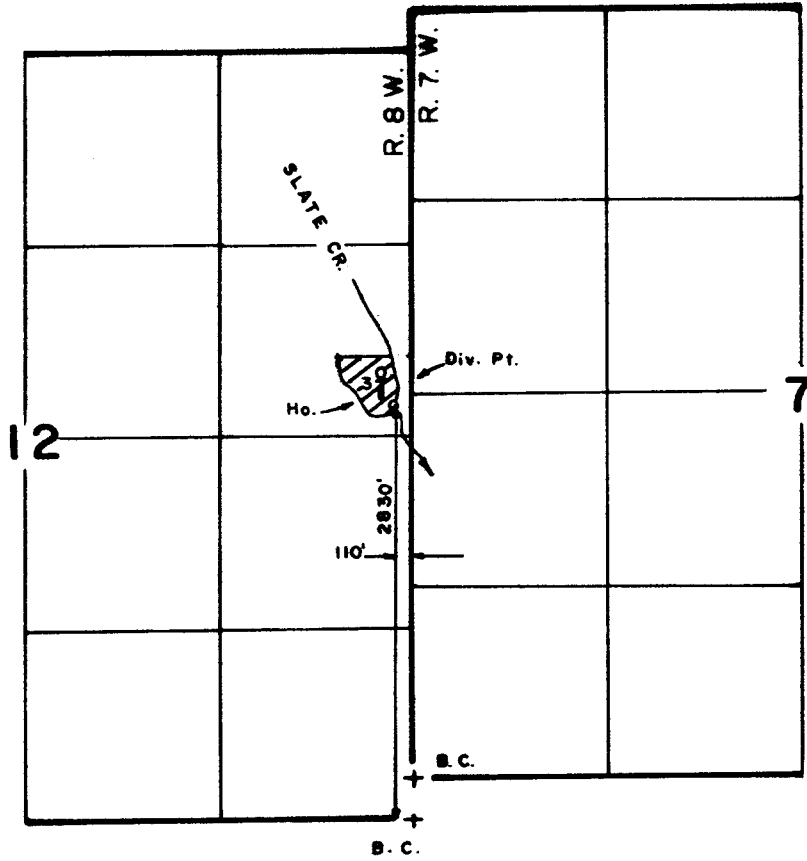

Scale: 1" = 1320'

RECEIVED

JUL 14 1988

FINAL PROOF SURVEY
UNDER

Application No. **54404** Permit No. **40800**
IN NAME OF

JETTE MC HENRY

Surveyed JUL 14 1986, by B.S. JAMES

11032-179-177 R