


T115 R5W WM

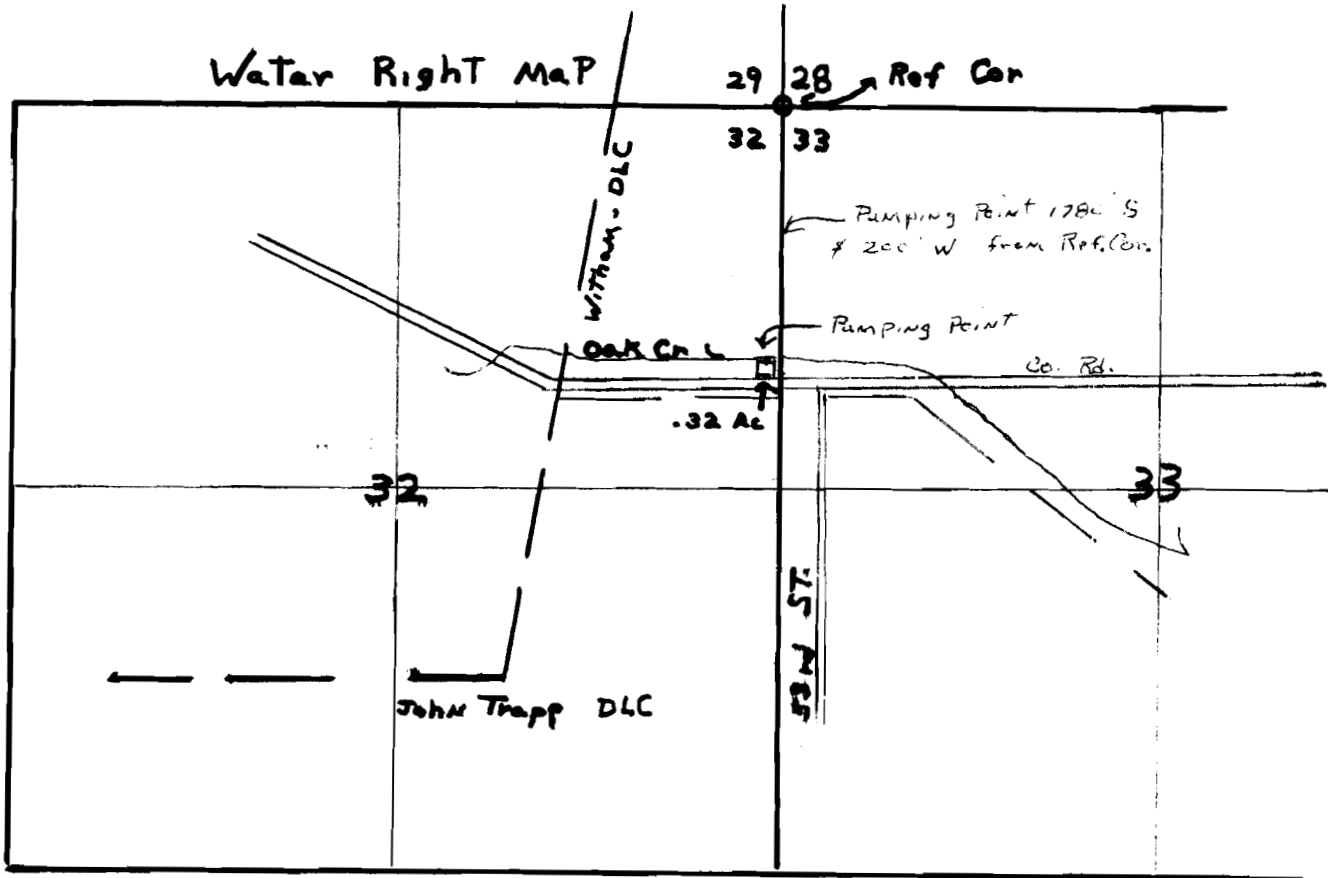

Application No. 54421
Permit No. 40809

Name — Elmer H. & Gay L. Gallaway
Address — 5525 N.W. Oak Creek Drive Corvallis, OR 97330

Scale 1" = 1320'