

RECEIVED

JUN 24 1976


WATER RESOURCES DEPT.
SALEM, OREGON

SW1/4 SEC. 29 T16S. R.12E.W.M.
DESCHUTES COUNTY

16 12 29C

1" = 400'

See Map 16 12 29B

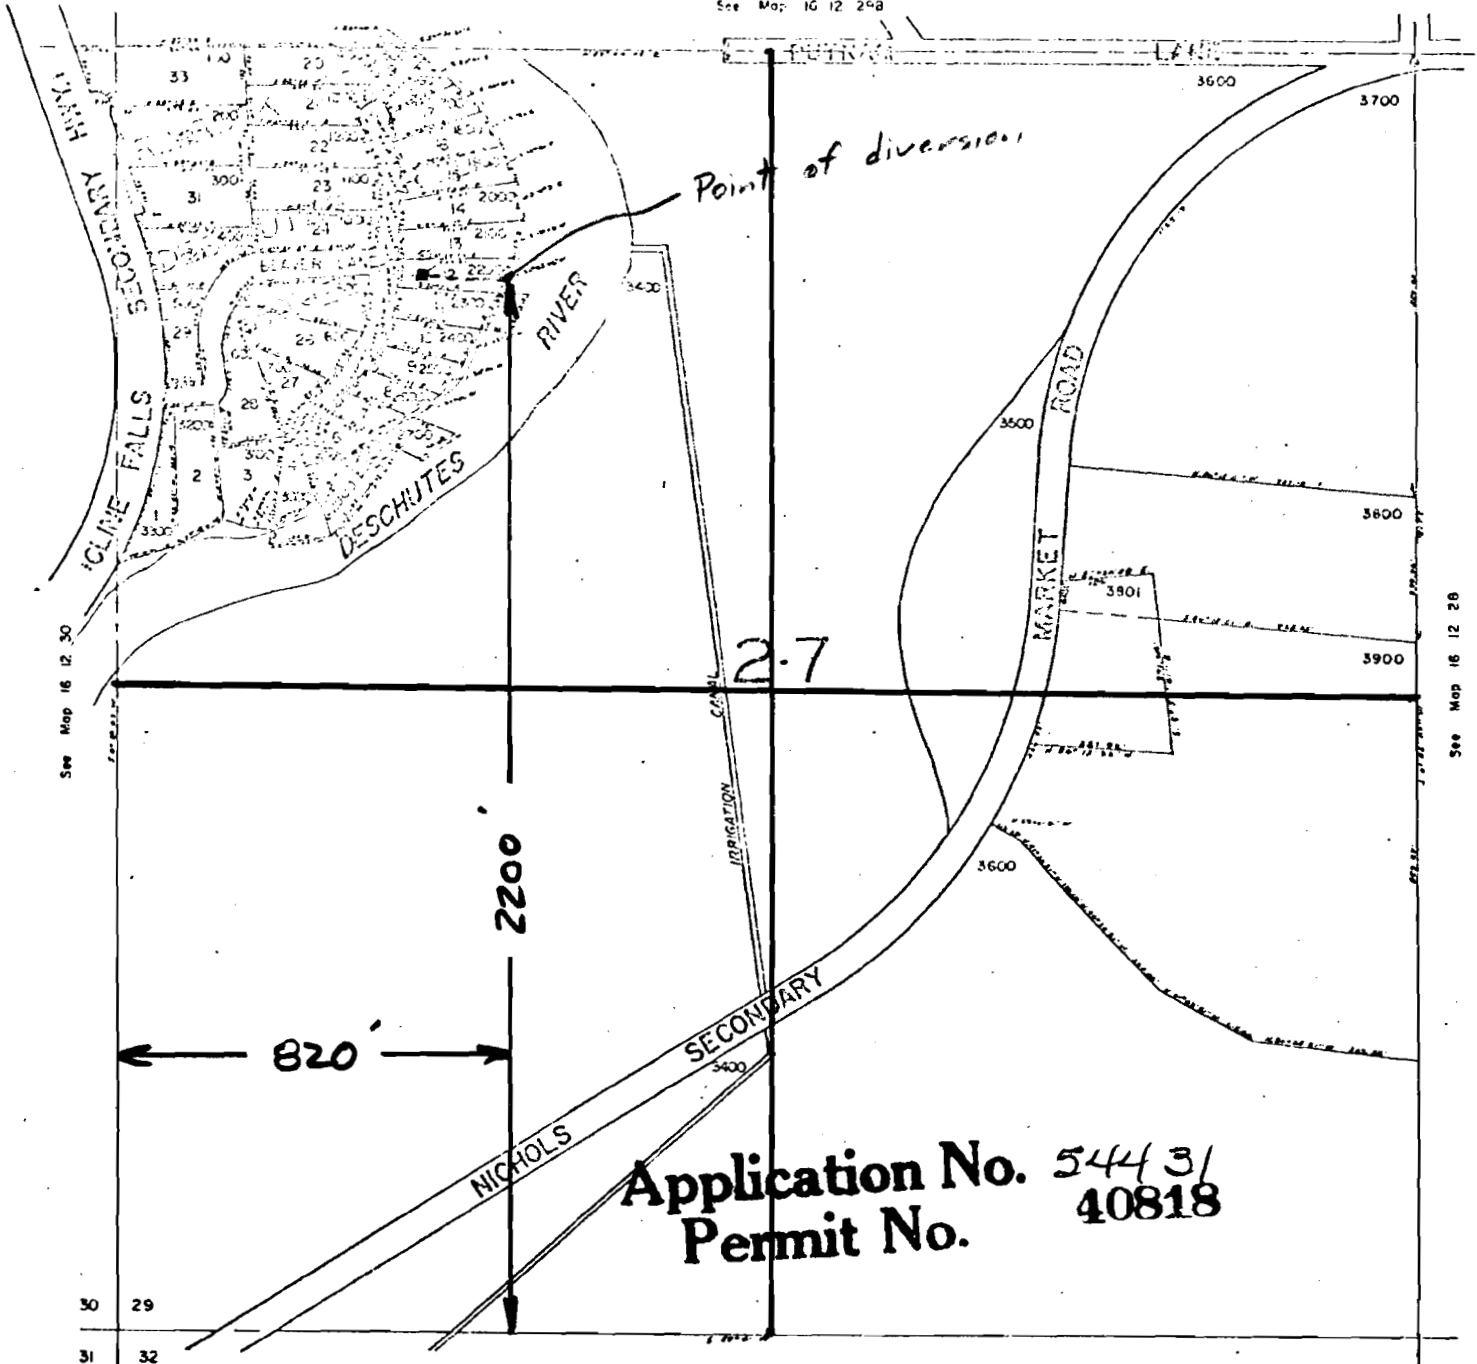

See Map 16 12 32

16 12 29C