


T. 34 S., R. 6 W., W. M.

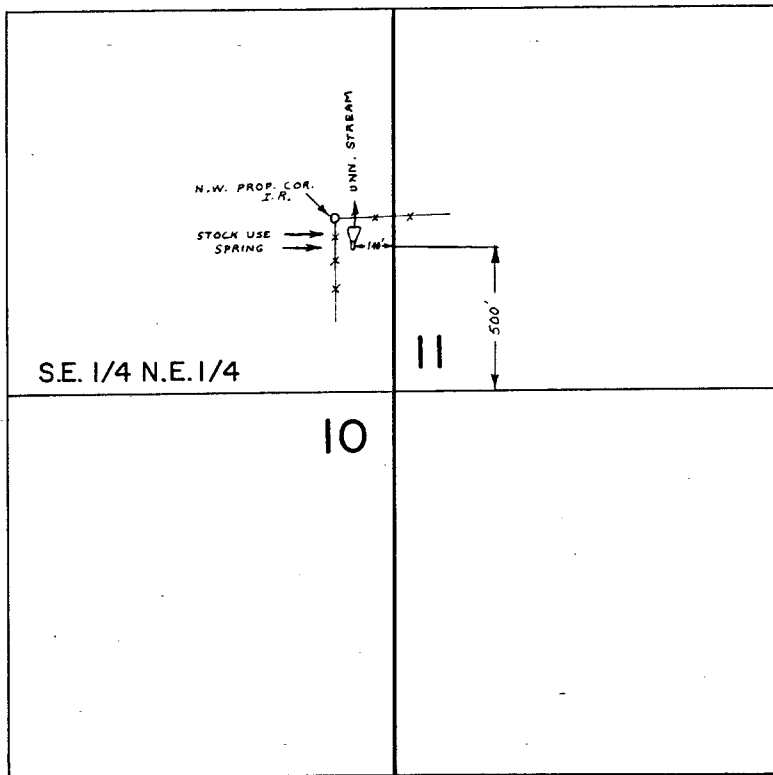

SCALE: 1" = 660 FT.

FINAL PROOF SURVEY
UNDER

Application No. 54466 Permit No. 40856
IN NAME OF

DAVID L. TRADER

Surveyed OCT. 25 1978 by B. SUND

RECEIVED
OCT 1 1981

WM. DIST. 14
GRANTS PASS, ORE.

PTS-1978-14-D