


T.28S., R7W6M., Section 2

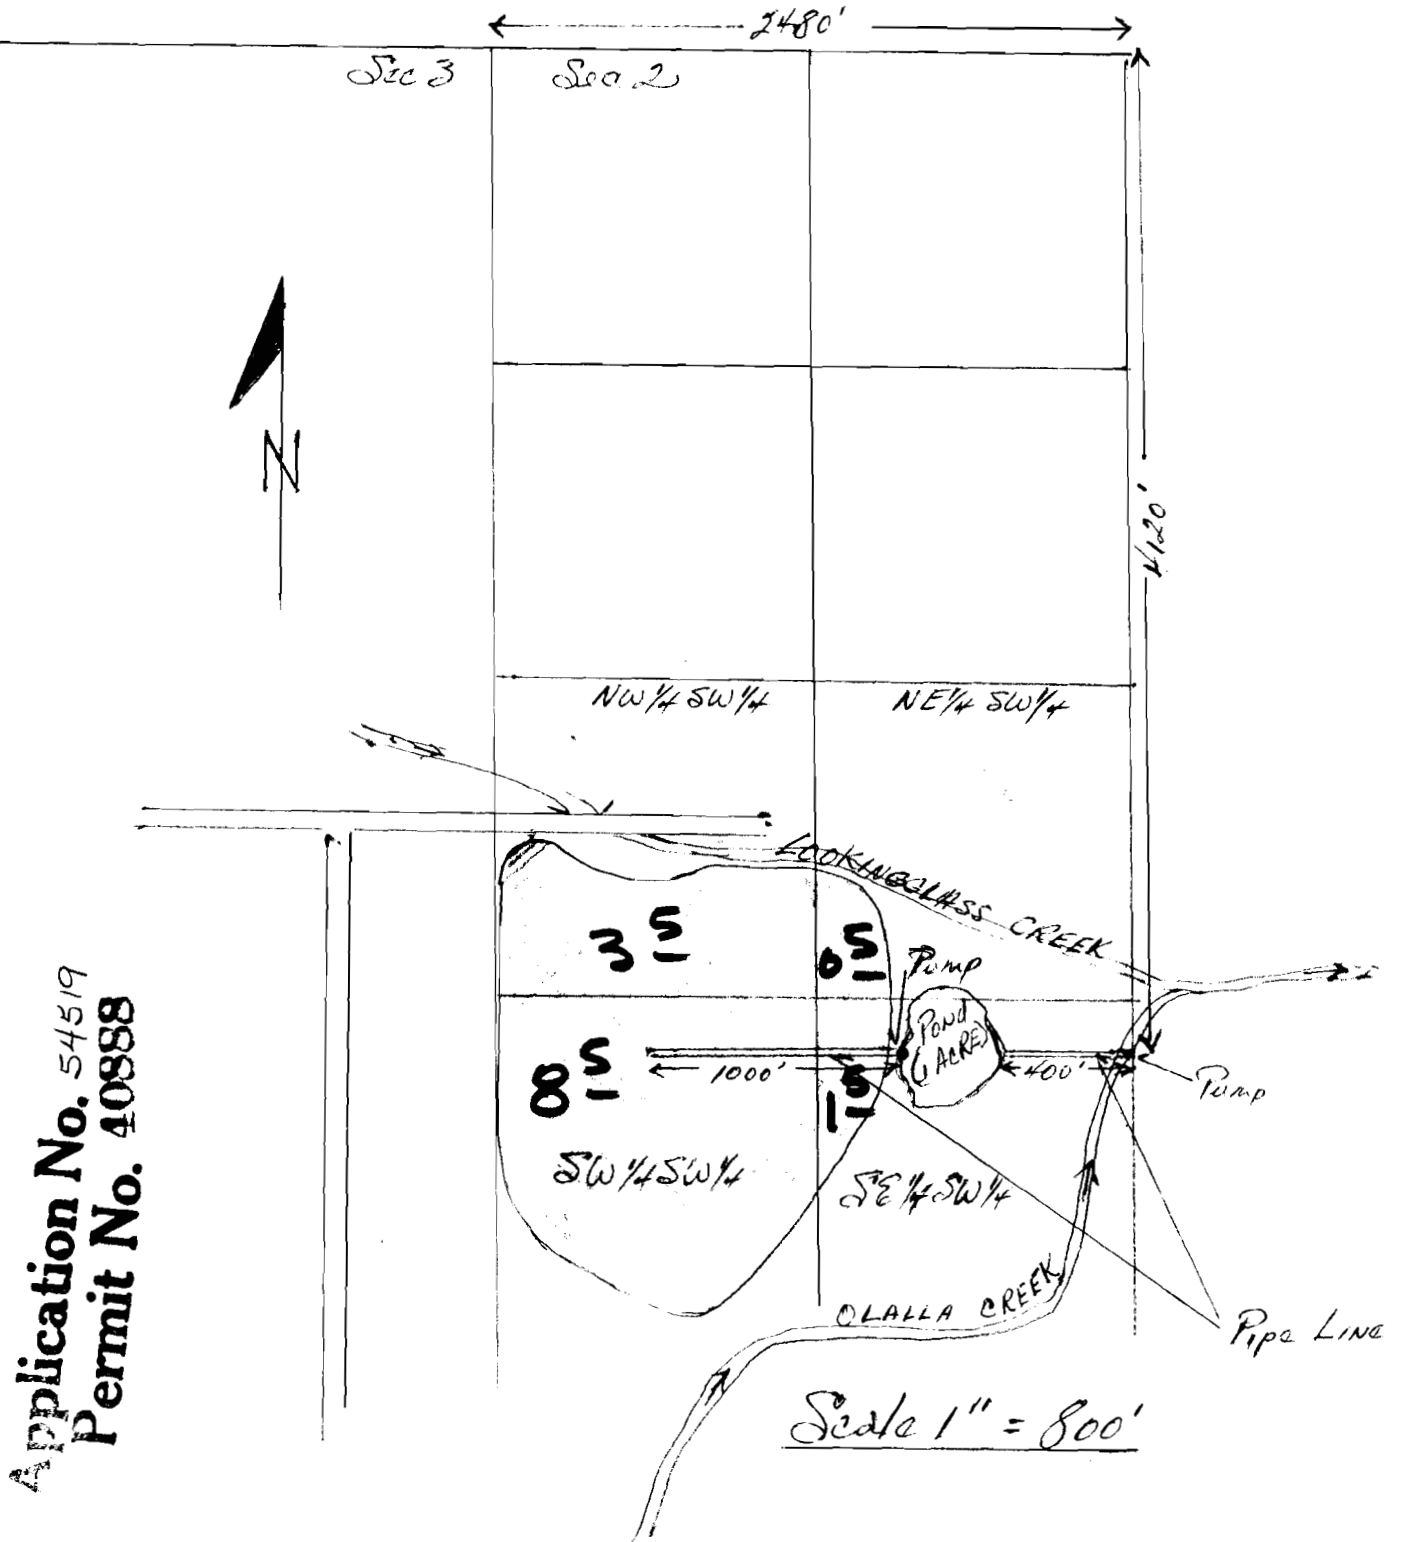

Boundige & Popken Trucking, Inc.

Rt 4 Box 691-7

Roseburg Oregon 97470

RECEIVED

WATER DIVISION