MAP OF
TUM-TUM LAKE RESERVOIR
—AND—
IRRIGATION SYSTEM

AS SURVEYED FOR

E.B. HILL, DENIO, OREGON.

Surveyed Aug. 10 to Sept. 1 1909 by

EASTERN OREGON ENGINEERING COMPANY,

—BURNS, OREGON.—

Scale 1in = 1000 ft.

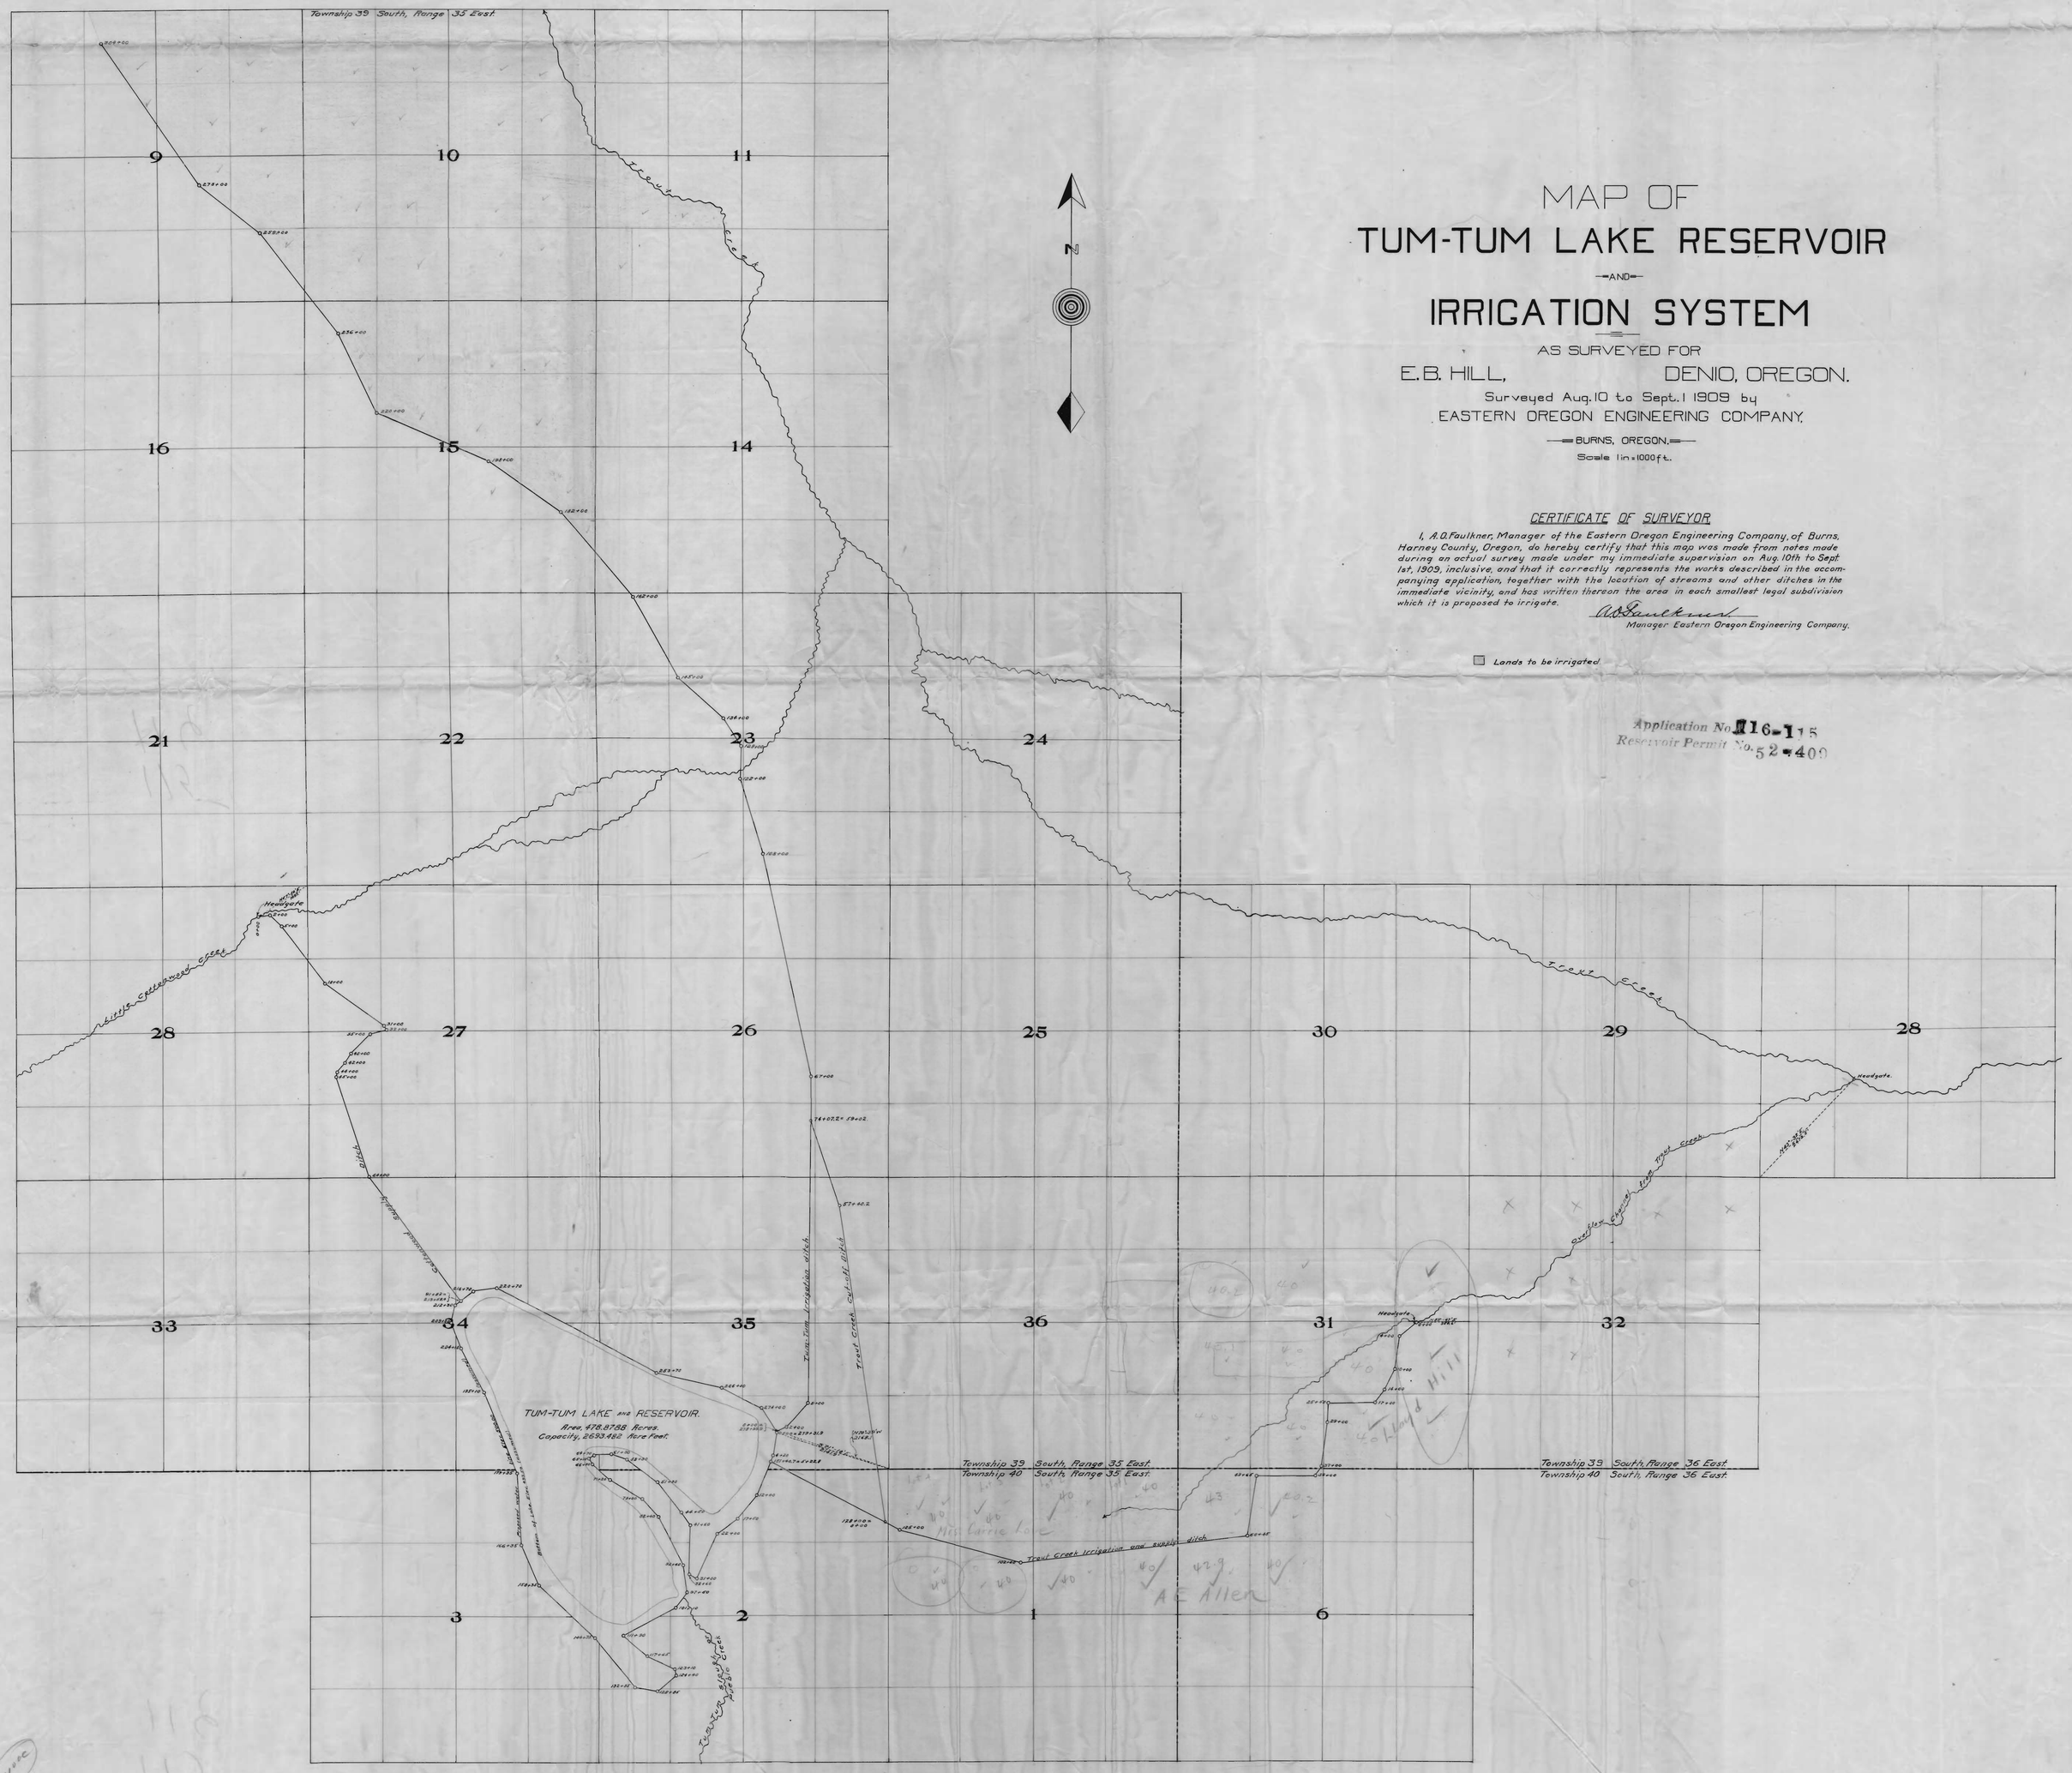

CERTIFICATE OF SURVEYOR

I, A.O. Faulkner, Manager of the Eastern Oregon Engineering Company, of Burns, Harney County, Oregon, do hereby certify that this map was made from notes made during an actual survey made under my immediate supervision on Aug. 10th to Sept. 1st, 1909, inclusive, and that it correctly represents the works described in the accompanying application, together with the location of streams and other ditches in the immediate vicinity, and has written thereon the area in each smallest legal subdivision which it is proposed to irrigate.

A.O. Faulkner
Manager Eastern Oregon Engineering Company.

☐ Lands to be irrigated

Application No. 116-115
Reservoir Permit No. 52-409