


NORLYN B. STEPHENS

1136 E. ALDER ST.  
WALLA WALLA, WASH.  
99362

SCALE 8" = 1 MILE

T 34 S R 7 E

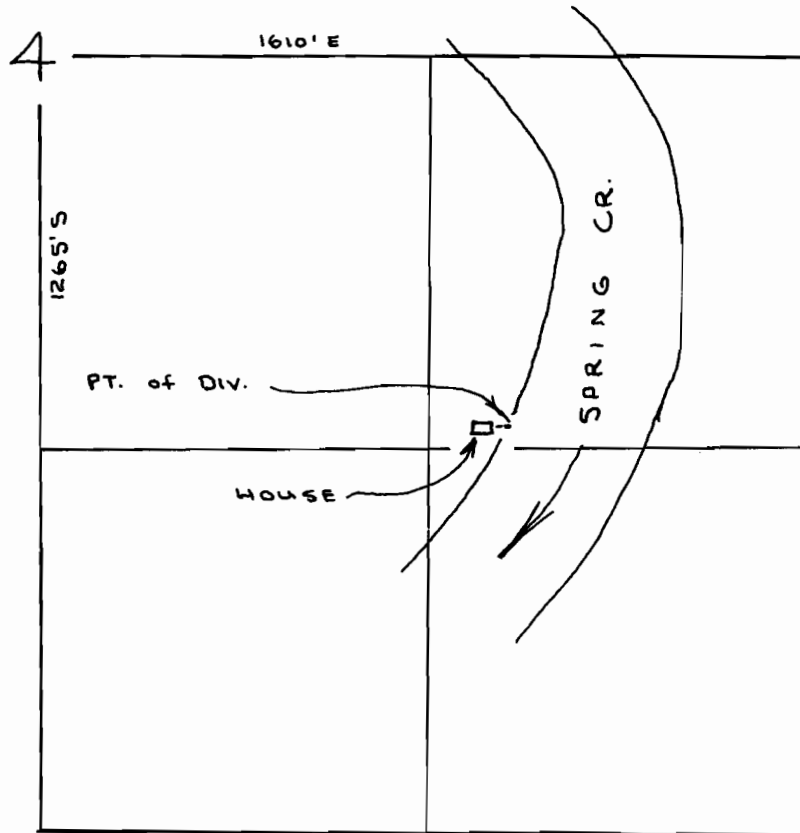

Application No. 54544  
Permit No. 40920