


RECEIVED

JUL 28 1976

RESOURCES DEPT.

T15 R4W
SW 1/4 Sec. 10
scale 1" = 400'

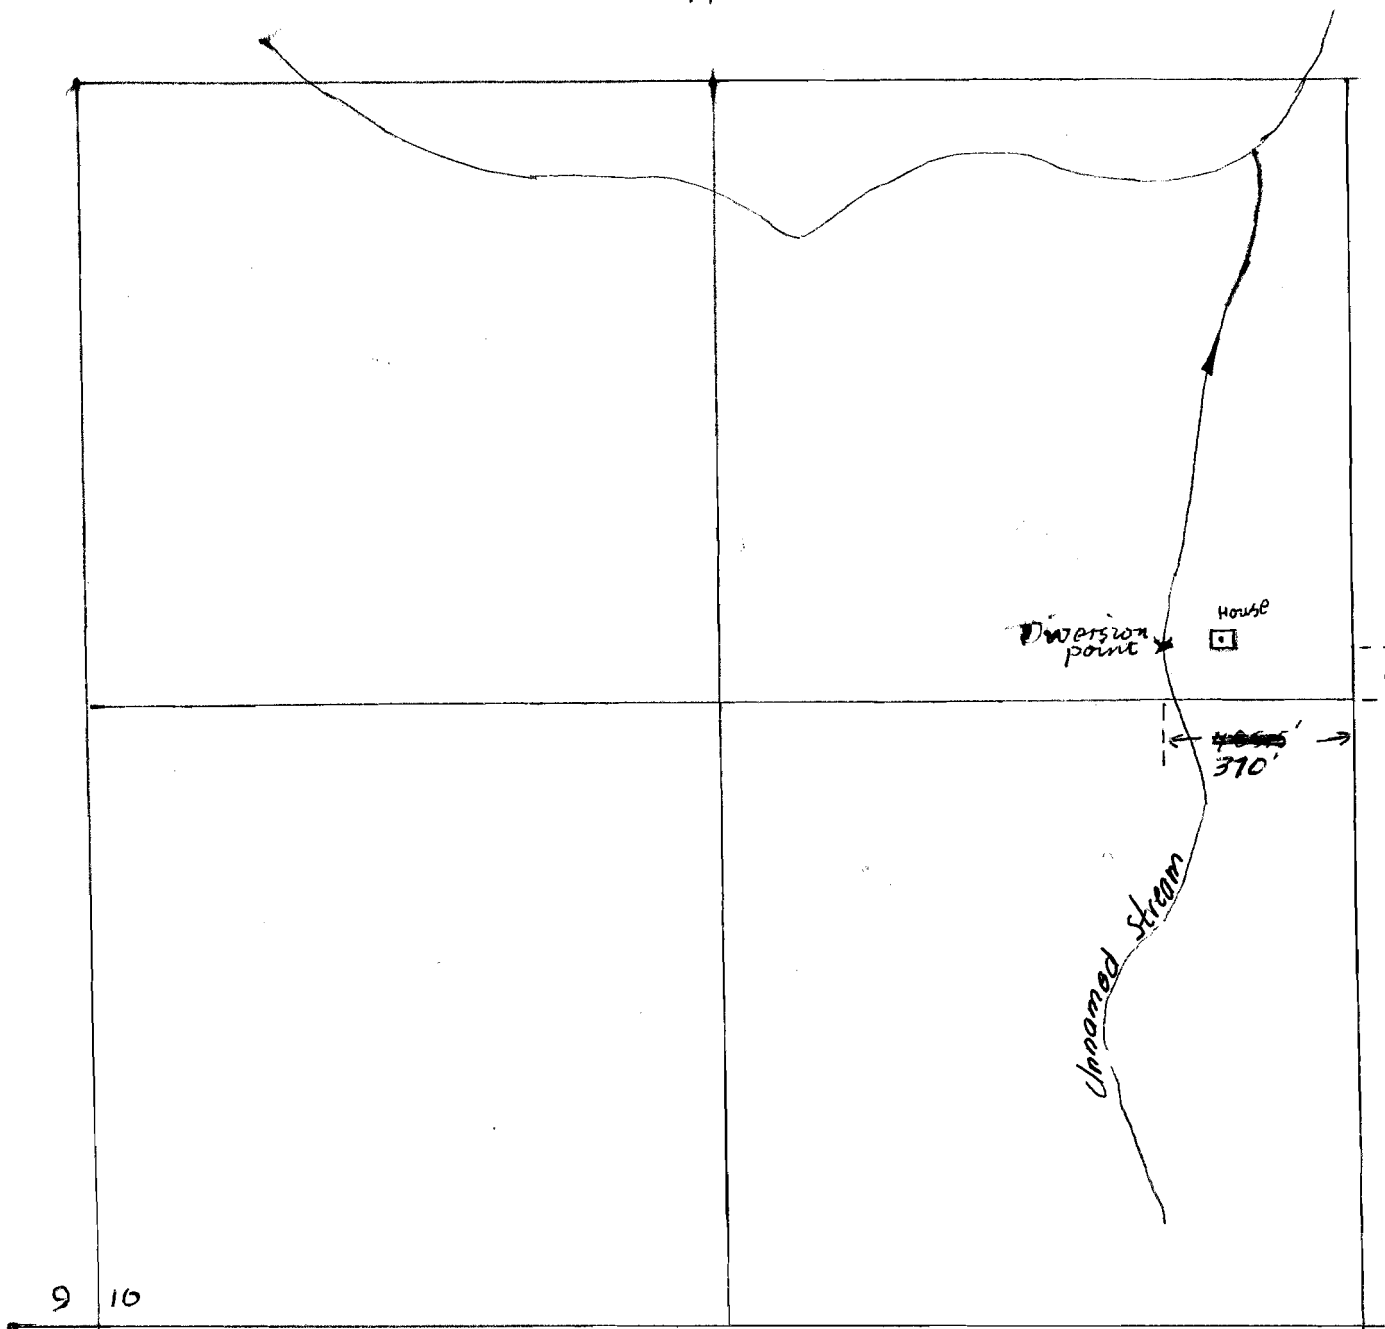

Application No. 54553
Permit No. 40937