


PC 20

2220

PC 20
2004

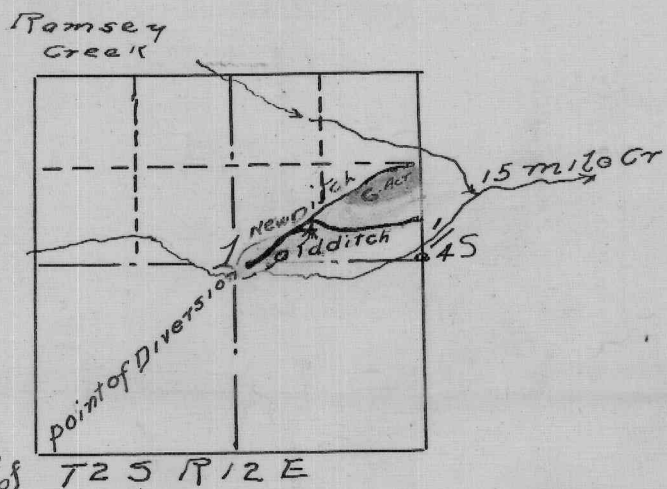

815ch South and
 2.15 Chs west of
 NE cor of SW 1/4 of NE 1/4
 Sec 1 T25 R12 E W 1/2

Map of E.D. Roberts Ditch.

I A W Mohr hereby certify that that this map was made from notes taken from an actual survey made by me on April 25-1919 and that it correctly represents the works shown hereon and described in the accompanying application together with the streams & other ditches in the immediate vicinity

A W Mohr
 County Surveyor

PC 20

Application No. 6539
 Permit No. 4095

