


T. 26 S. R. 4 W. NW¹ SEC. 15

9 | 10

1" = 200'

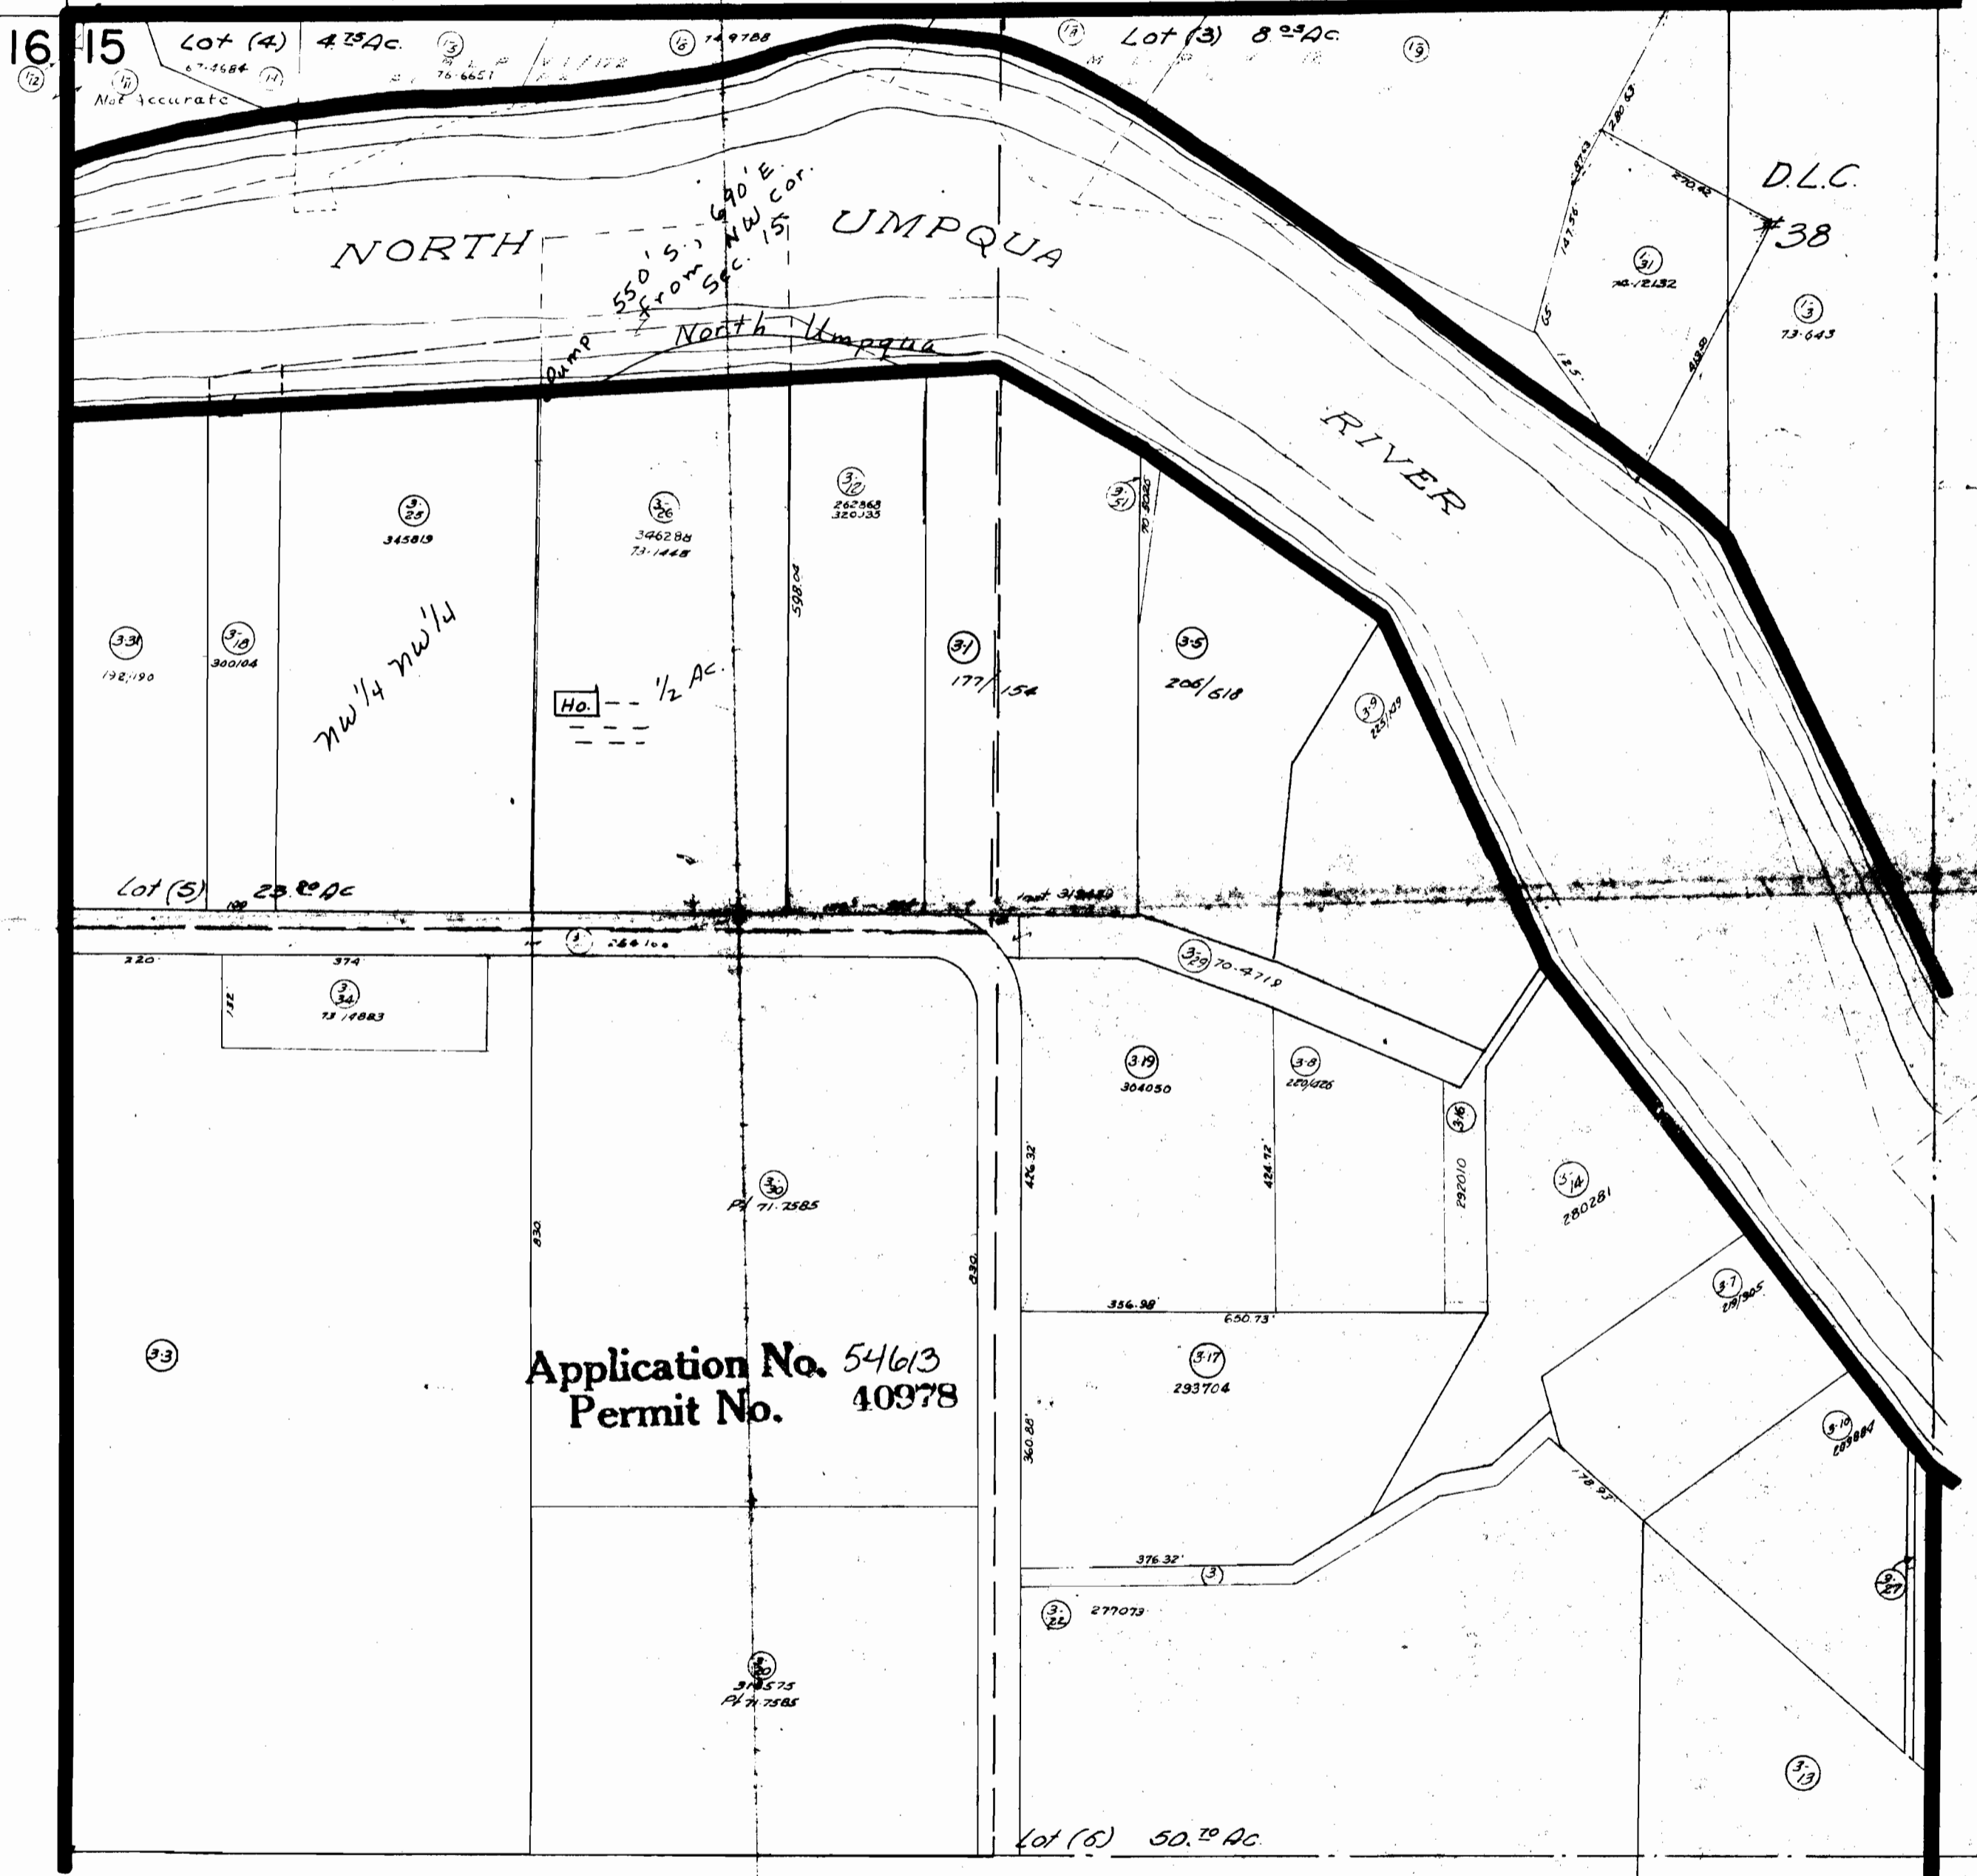

Application No. 54613
Permit No. 40978

RECEIVED
MAY 10 1978
WATER RESOURCES DEPT.
