


**RECEIVED**  
JUL 27 1976  
WATER RESOURCES DEPT  
SALEM, OREGON

**RECEIVED**  
JUL 27 1976  
WATER RESOURCES DEPT  
SALEM, OREGON

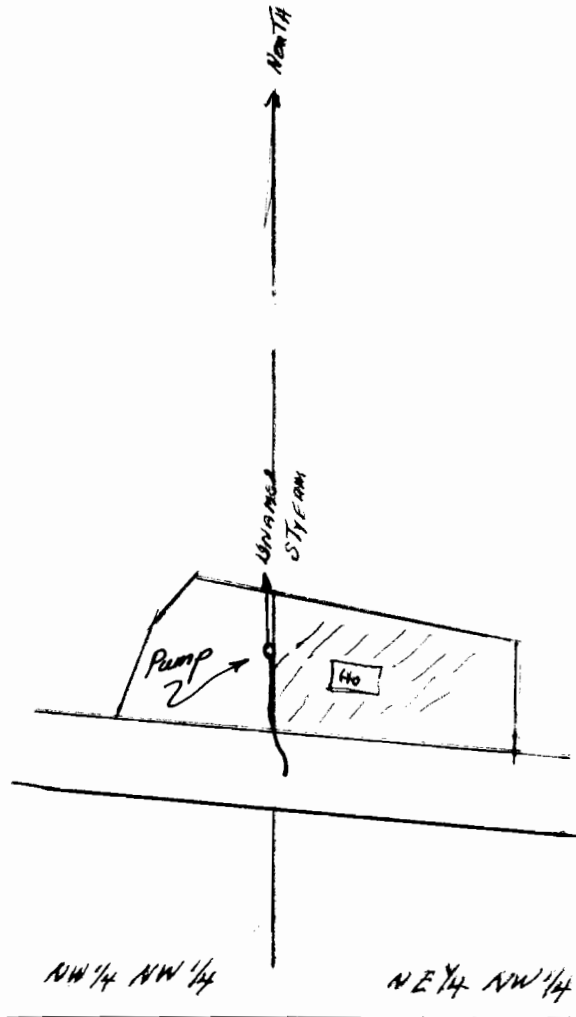

**Application No.** 54624  
**Permit No.** 40986

pump: 380' dia, 10 ft w.  
from SW cor of the NE 1/4 NW 1/4  
Sec 6, T33S, R14W, W.M.  
1" = 200 ft.