


T. 26 S., R. 6 W. W. M.

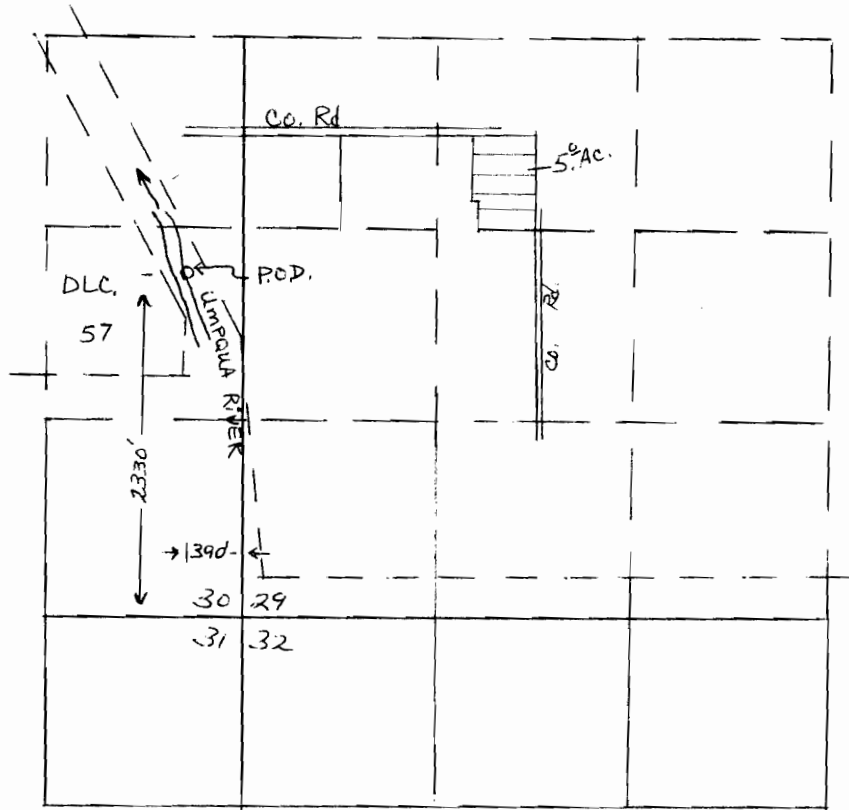

Scale: 4" = 1 mile



Application No. 54678  
Permit No. 41024

RECEIVED

LOTS 1-5 NASH ACRES  
Subdivision Douglas Co  
Oregon -

V. E. SUTTON