


The sketch below is made solely for the purpose of assisting in locating said premises and the Company assumes no liability for variations, if any, in dimensions and location ascertained by actual survey.

Pioneer National Title Insurance Company
Title and Trust Division

T 3N R 11E

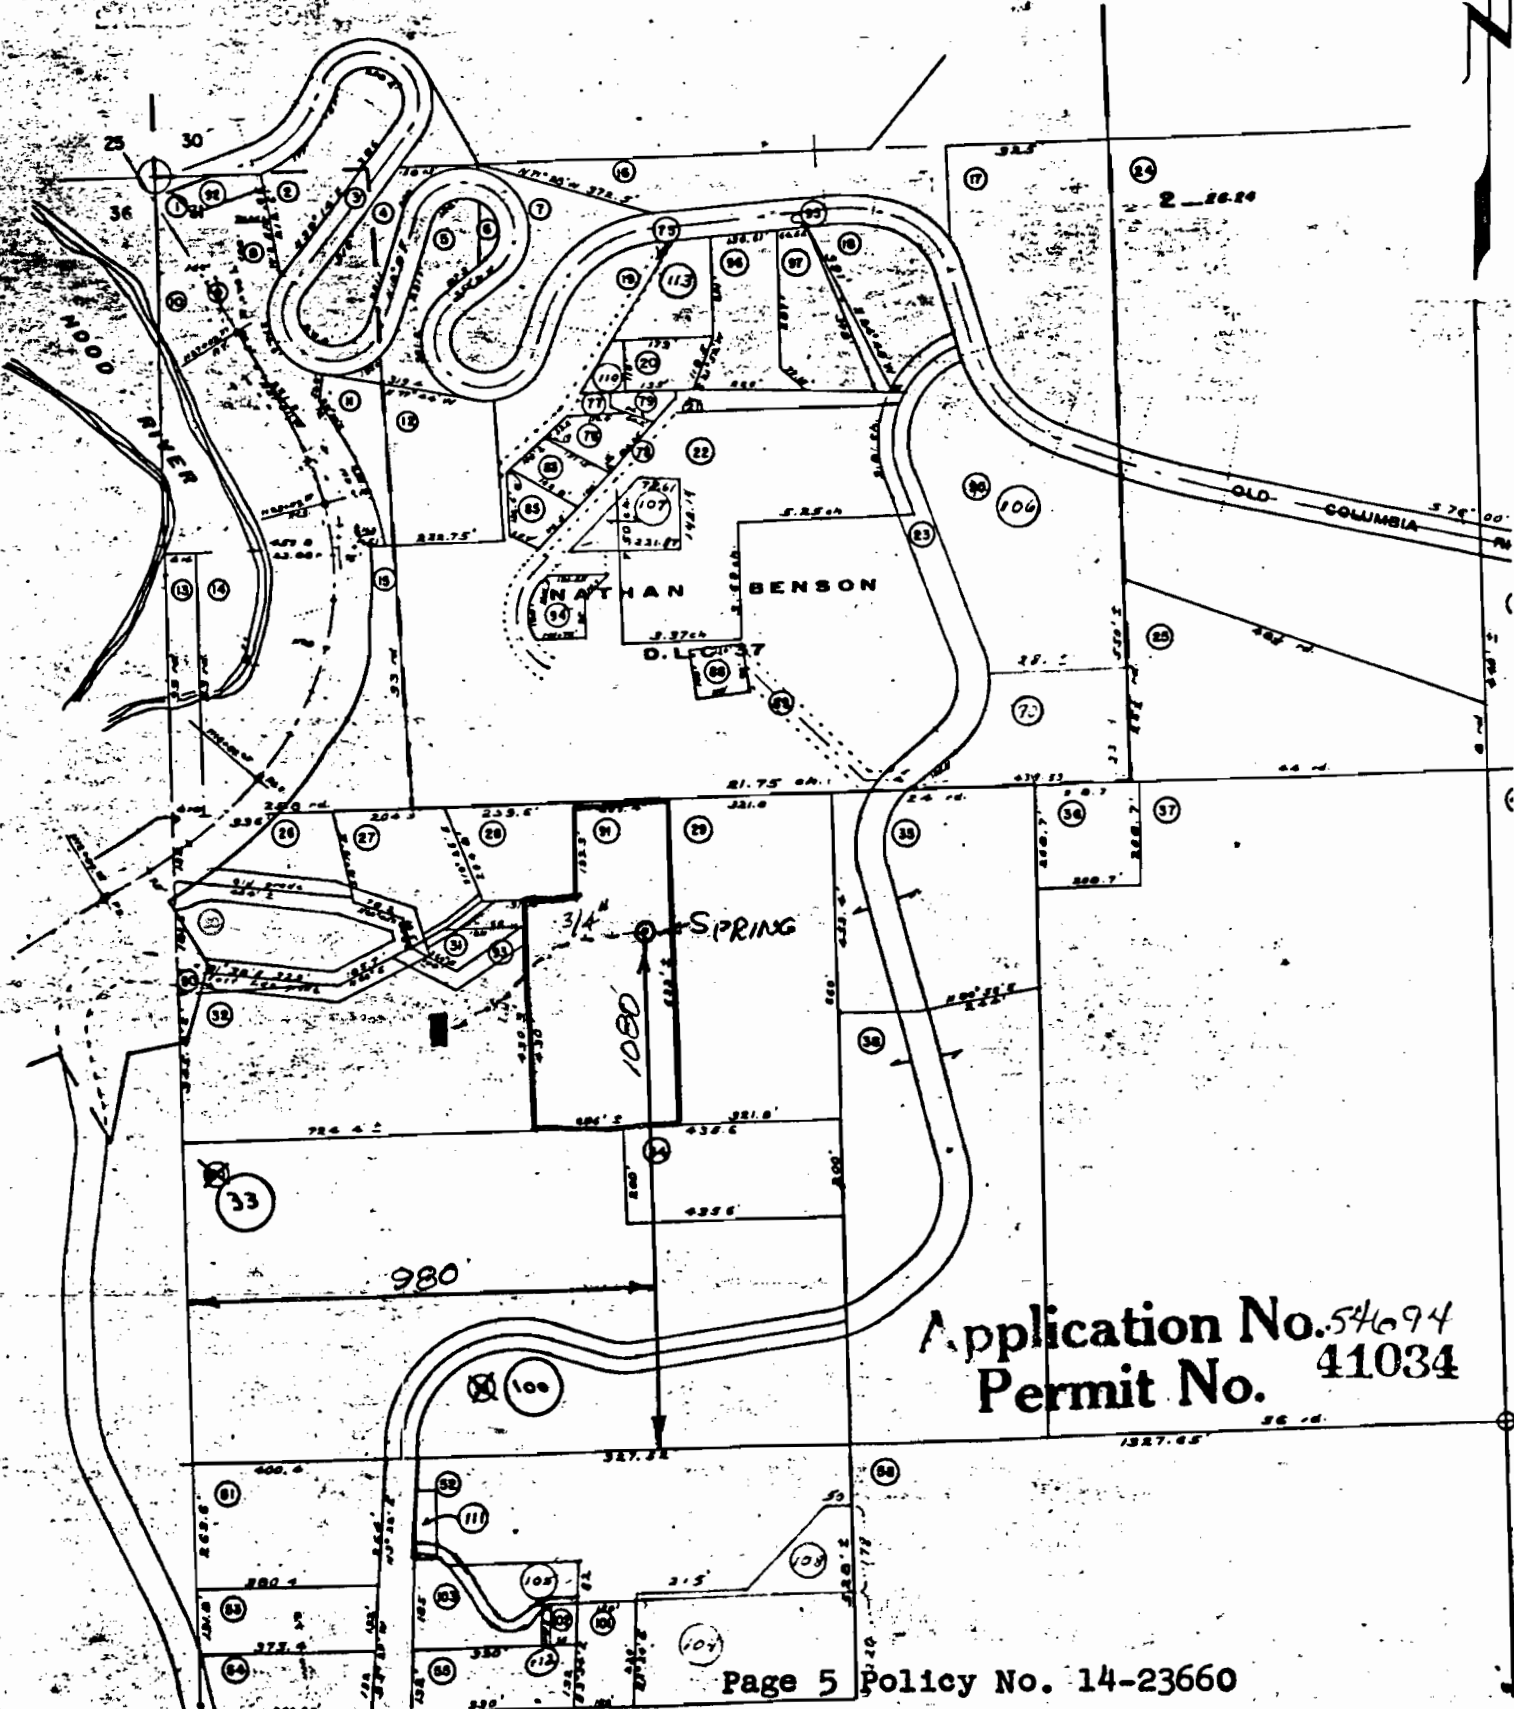

Application No. 54694
Permit No. 41034