

RECEIVED

JUL 1 1976

RESOURCES DEPT.


OREGON

RECEIVED

AUG 14 1970

STATE ENGINEER  
SALEM, OREGON

T. I. N., R. 4 E.

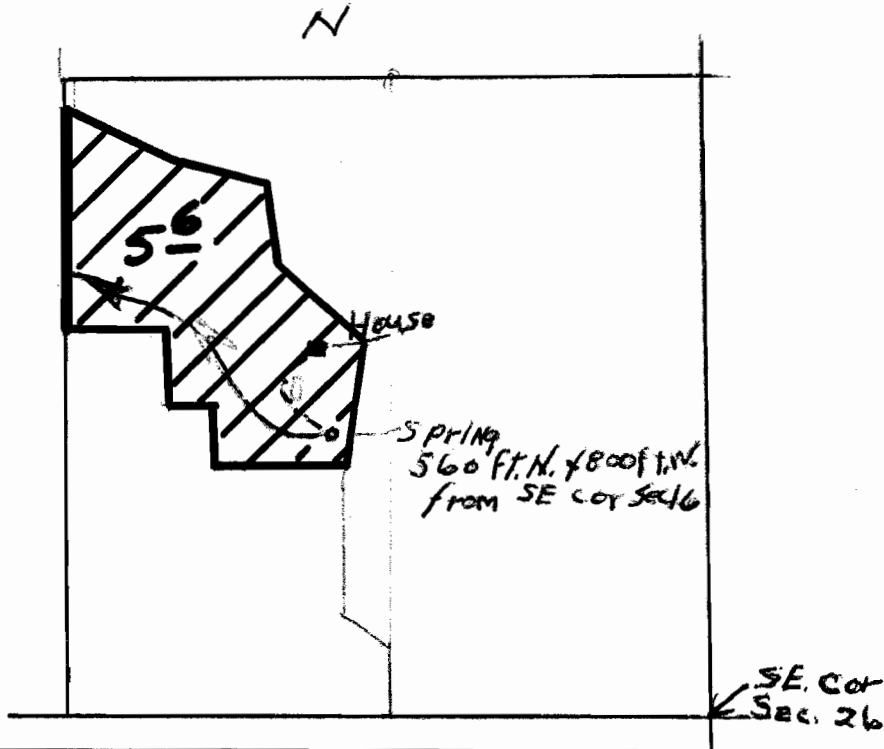

1" = 400'

Application No. 47403  
 Permit No. 35067

Application No. 54767  
 Permit No. 41083

RECEIVED  
 JAN 18 1971  
 STATE ENGINEER  
 SALEM, OREGON