T. 39 S., R. 5 W., W.M.

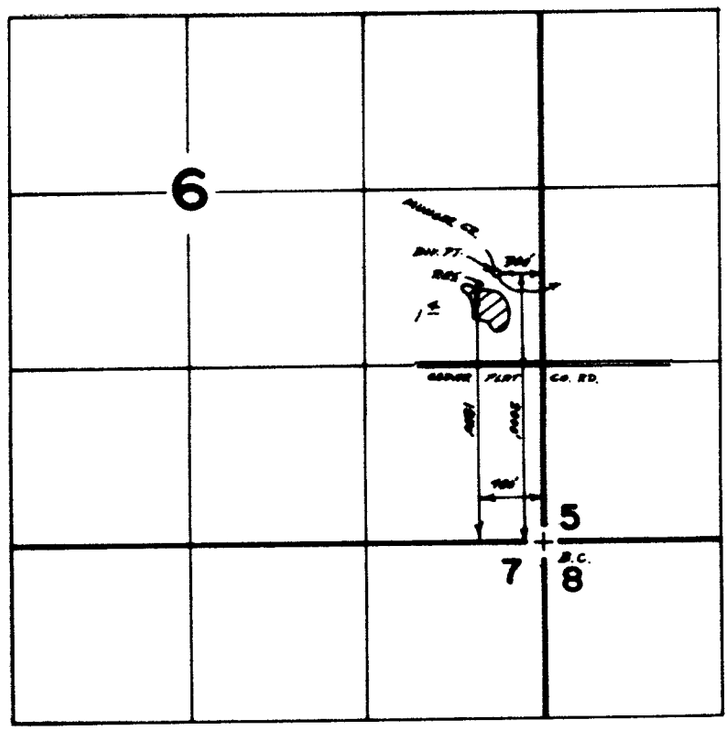

Scale 1"=1320'

FINAL PROOF SURVEY
UNDER

R-54800 R-6547

Application No. 54801 Permit No. 41085

IN NAME OF

LLOYD D. & JACQUELINE D. REEDER

Surveyed Aug. 15, 1984, by B.S. JAMES

1988

41033-172-876