


T.40S., R.8W., W.M.

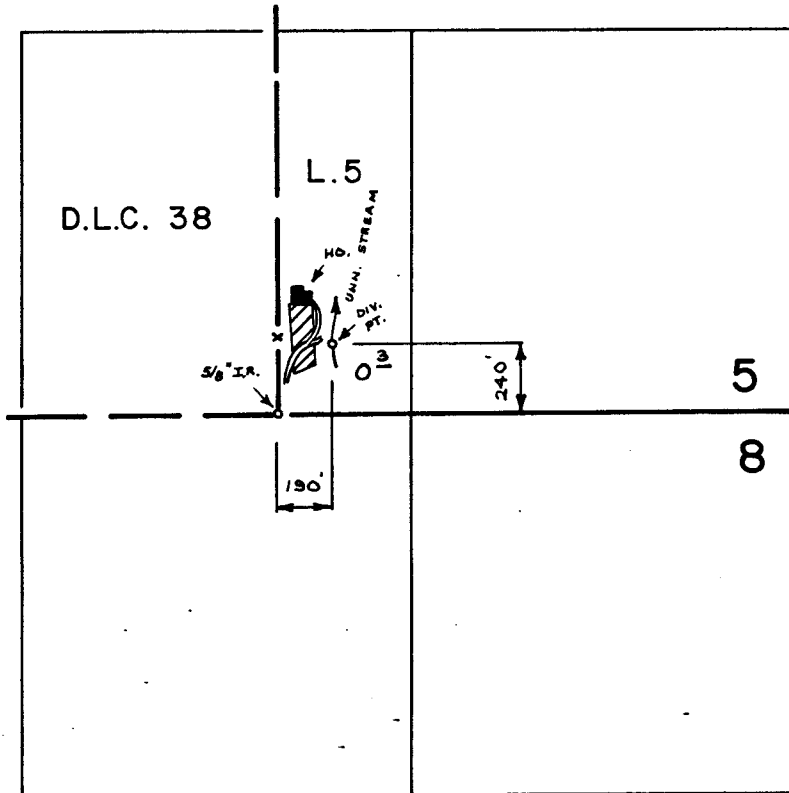

SCALE : 1" = 660 FT.

RECEIVED

OCT 1 1981

WM. DIST. 14
GRANTS PASS, ORE.

FINAL PROOF SURVEY
UNDER

Application No. 54772 Permit No. 41096
IN NAME OF

FLOYD H. NORRISS

Surveyed AUG. 8 1978, by B. SUND

D.H.M.
P.T.S. - 1978 - 14 - C