


8 11 13 A A

See Map 8 11 12

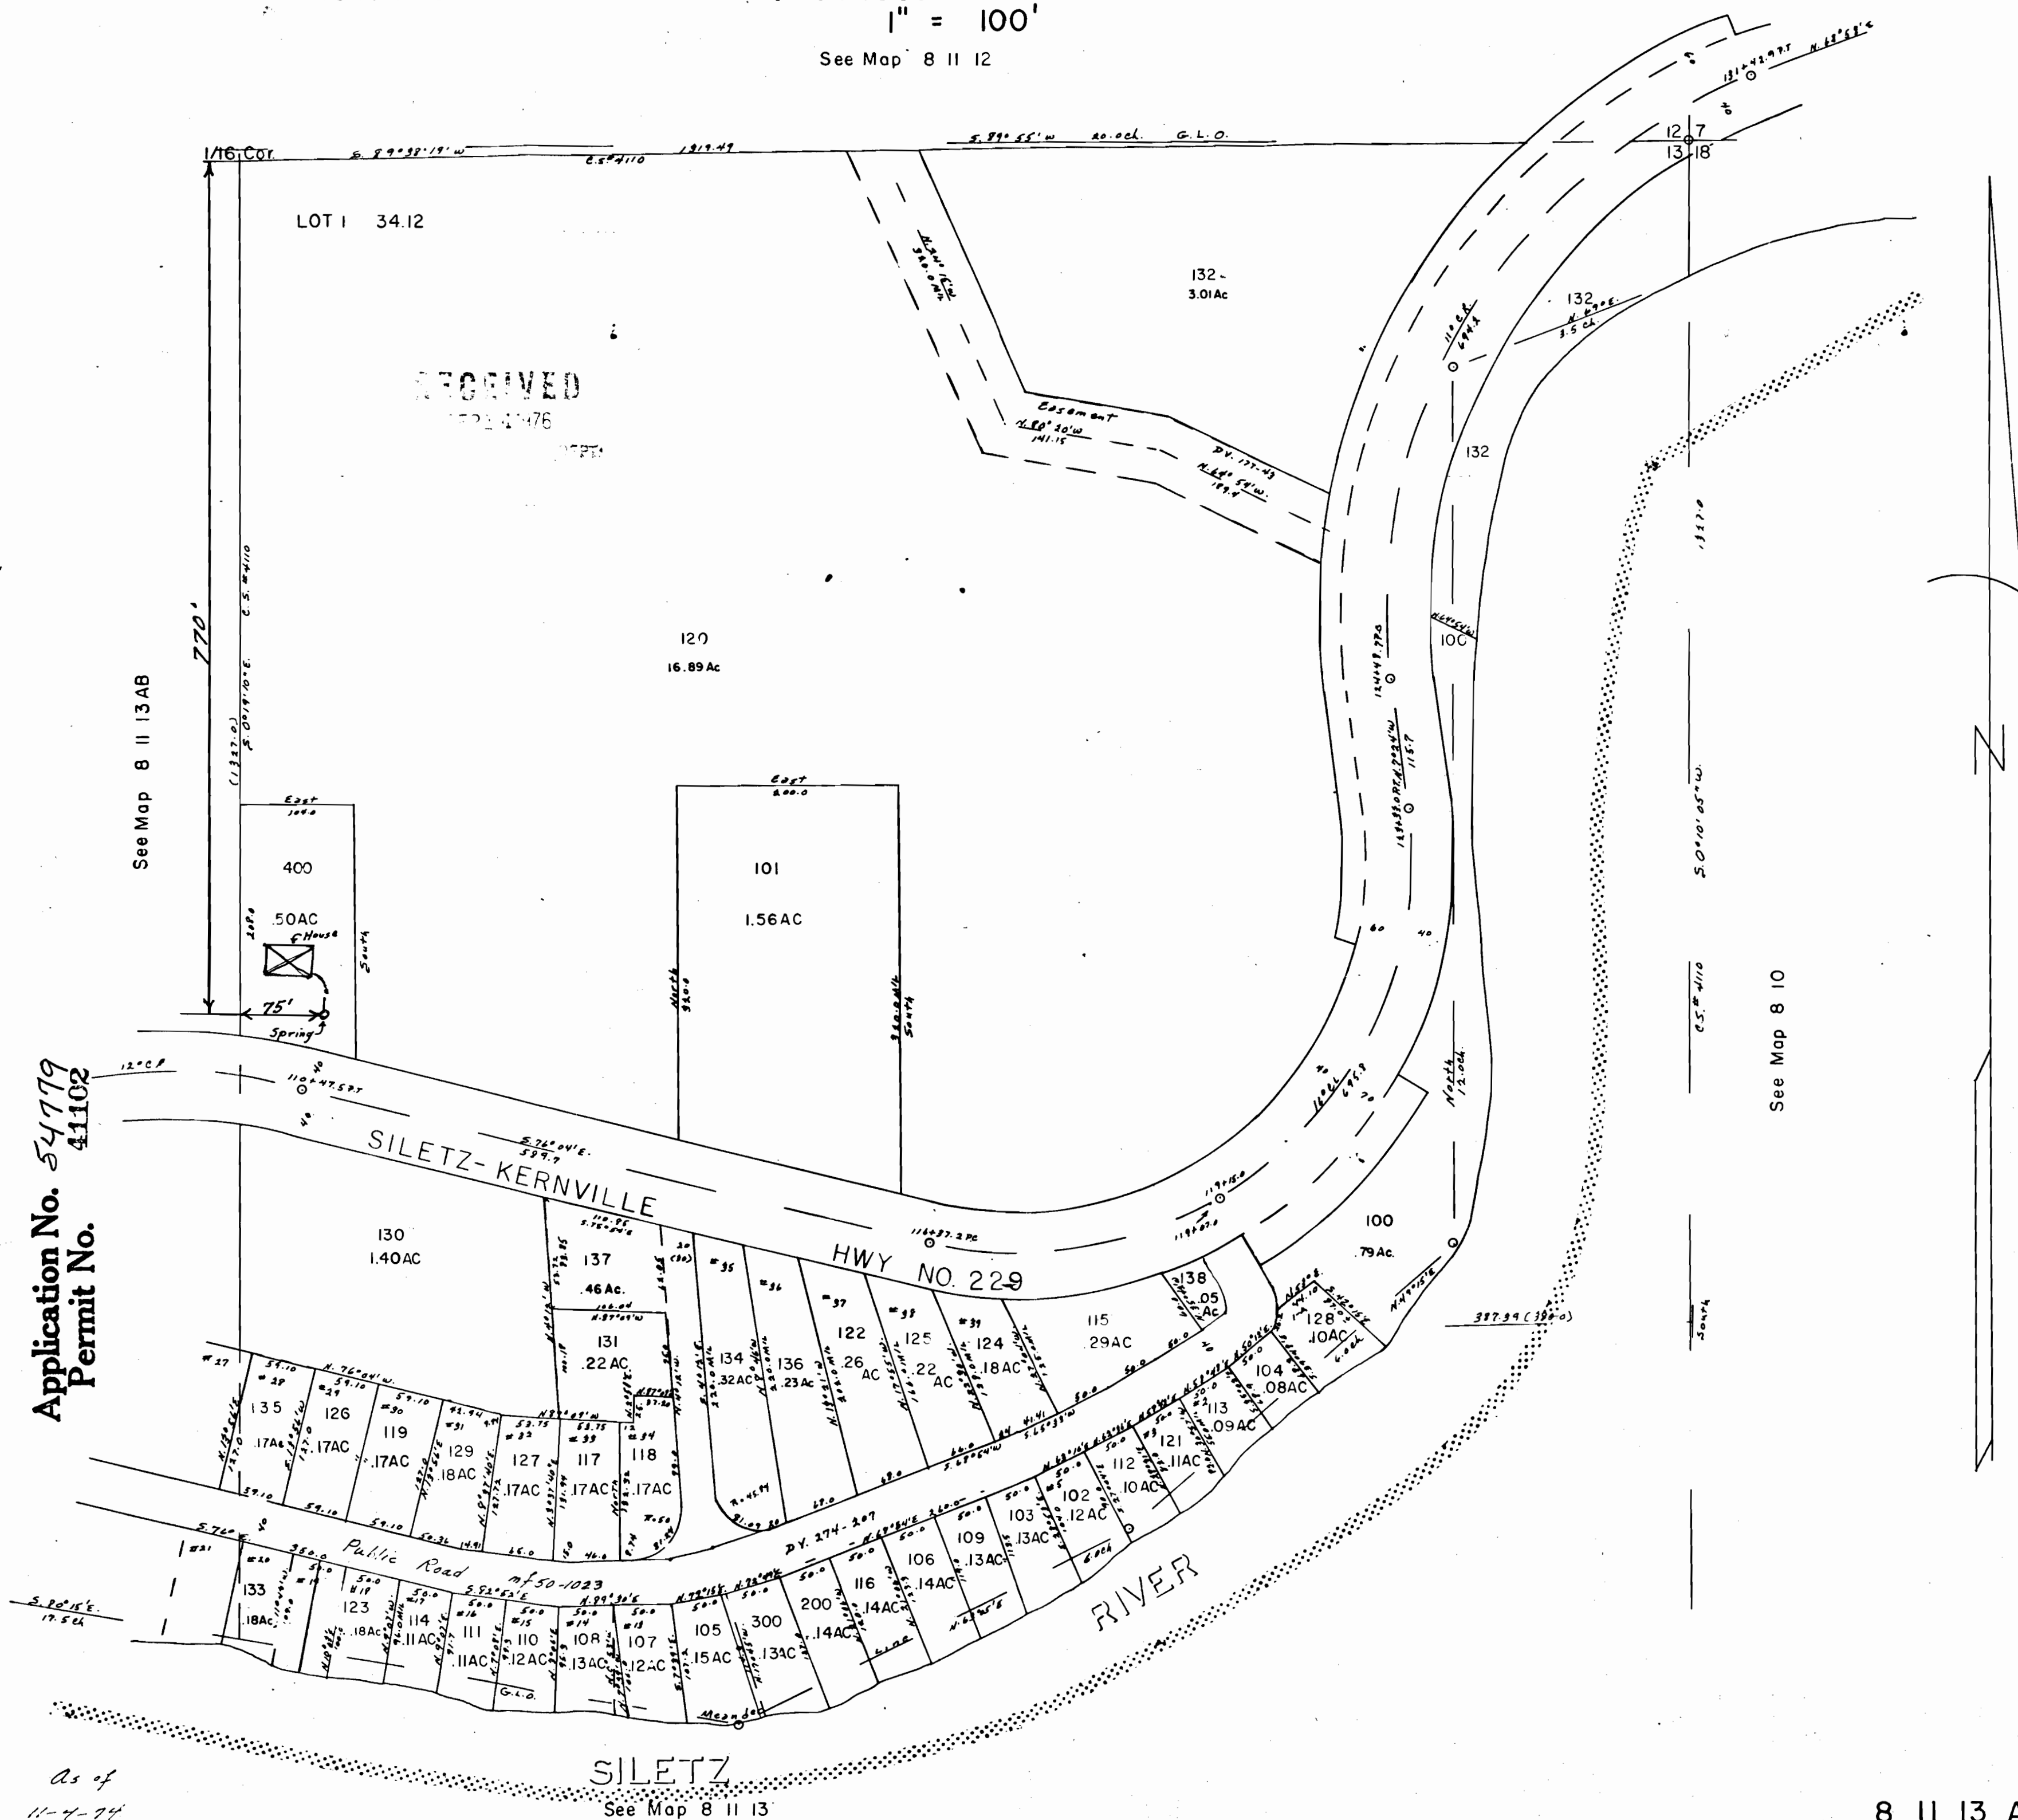

8 11 13 AA