


Permit: S 41107  
Volume: 1A  
Strm: UNN STR>S FK ROCKY  
Trib: ROGUE RIVER  
Priority: 9/15/76

# T.34 S., R.8 W., W.M.

RECEIVED

APR 8 1986

WM. DIST. 14  
GRANTS PAGE, ORE

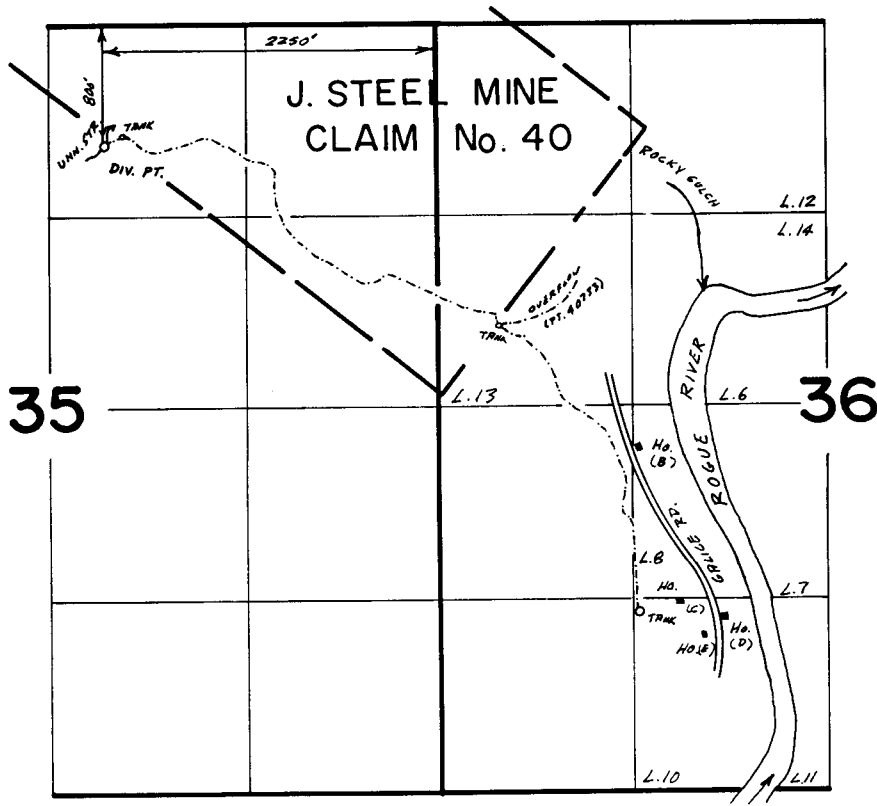

Scale 1"=1320'

- House B : KESTERSON
- House C : THOMASON
- House D : THOMASON
- House E : GILPIN

## FINAL PROOF SURVEY UNDER

Application No. ~~54788~~. Permit No. ~~41107~~.....  
IN NAME OF

GILBERT L. & MARY L. THOMASON

Surveyed JUNE 26 1984, by BS. JAMES.....