


T. 38 S. R. 6 W., W. M.

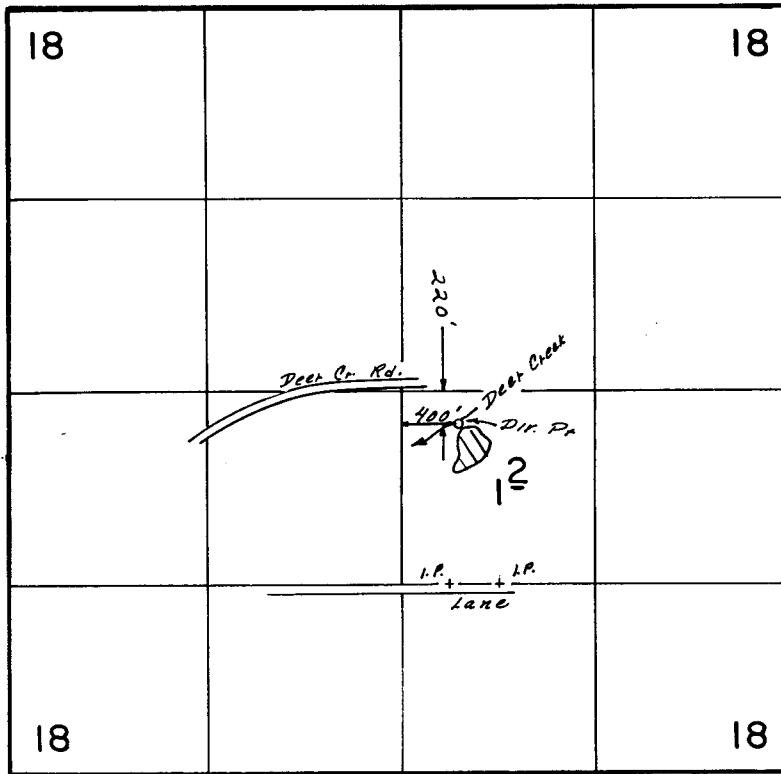

Scale: 1" = 1320'

RECEIVED

DEC 14 1988

REC'D DEC 14  
CLERK OF DIST. CLERK

**FINAL PROOF SURVEY**  
UNDER

Application No. **5.4839** Permit No. **4.11.38...**  
IN NAME OF

**GEORGE W. OWENS**

Surveyed **JUN...5...** 19**86**, by **B...S.....JAMES.**

41033-129-672 101