


T. 39S., R. 5W., W.M.

RECEIVED

JAN 23 1979

WM. DIST. 14  
GRANTS PASS, ORE.

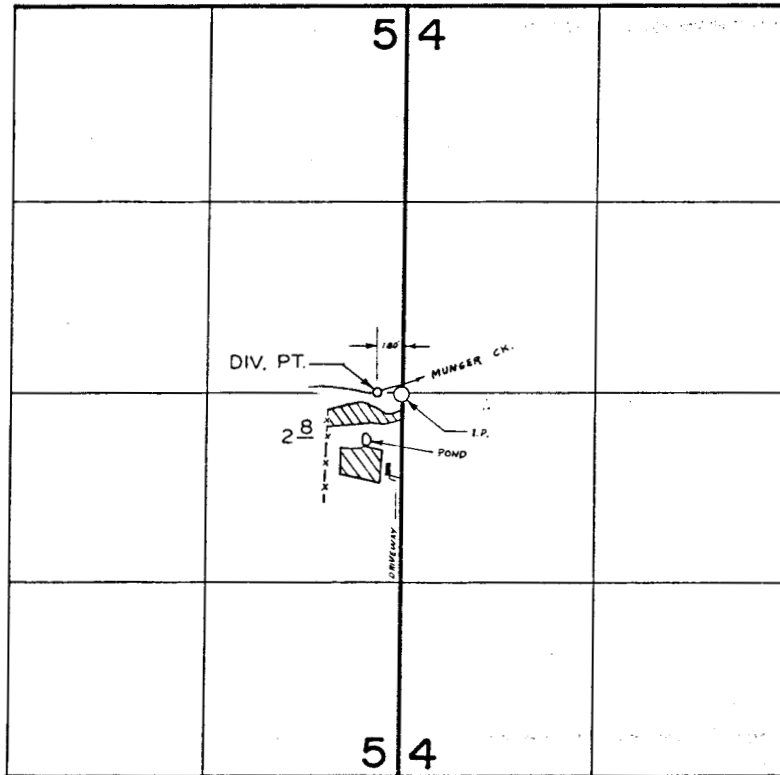

**FINAL PROOF SURVEY**  
UNDER

Application No. 54843... Permit No. 41140....  
IN NAME OF

.....DUANE R. REAGAN.....

Surveyed OCT. 19. 1977., by B. SUND.....