


The sketch below is made solely for the purpose of assisting in locating said premises and the Company assumes no liability for variations, if any, in dimensions and location ascertained by actual survey.

Pioneer National Title Insurance Company
A TICOR COMPANY

T. 15. R. 9 W. W. M.
1" = 400'

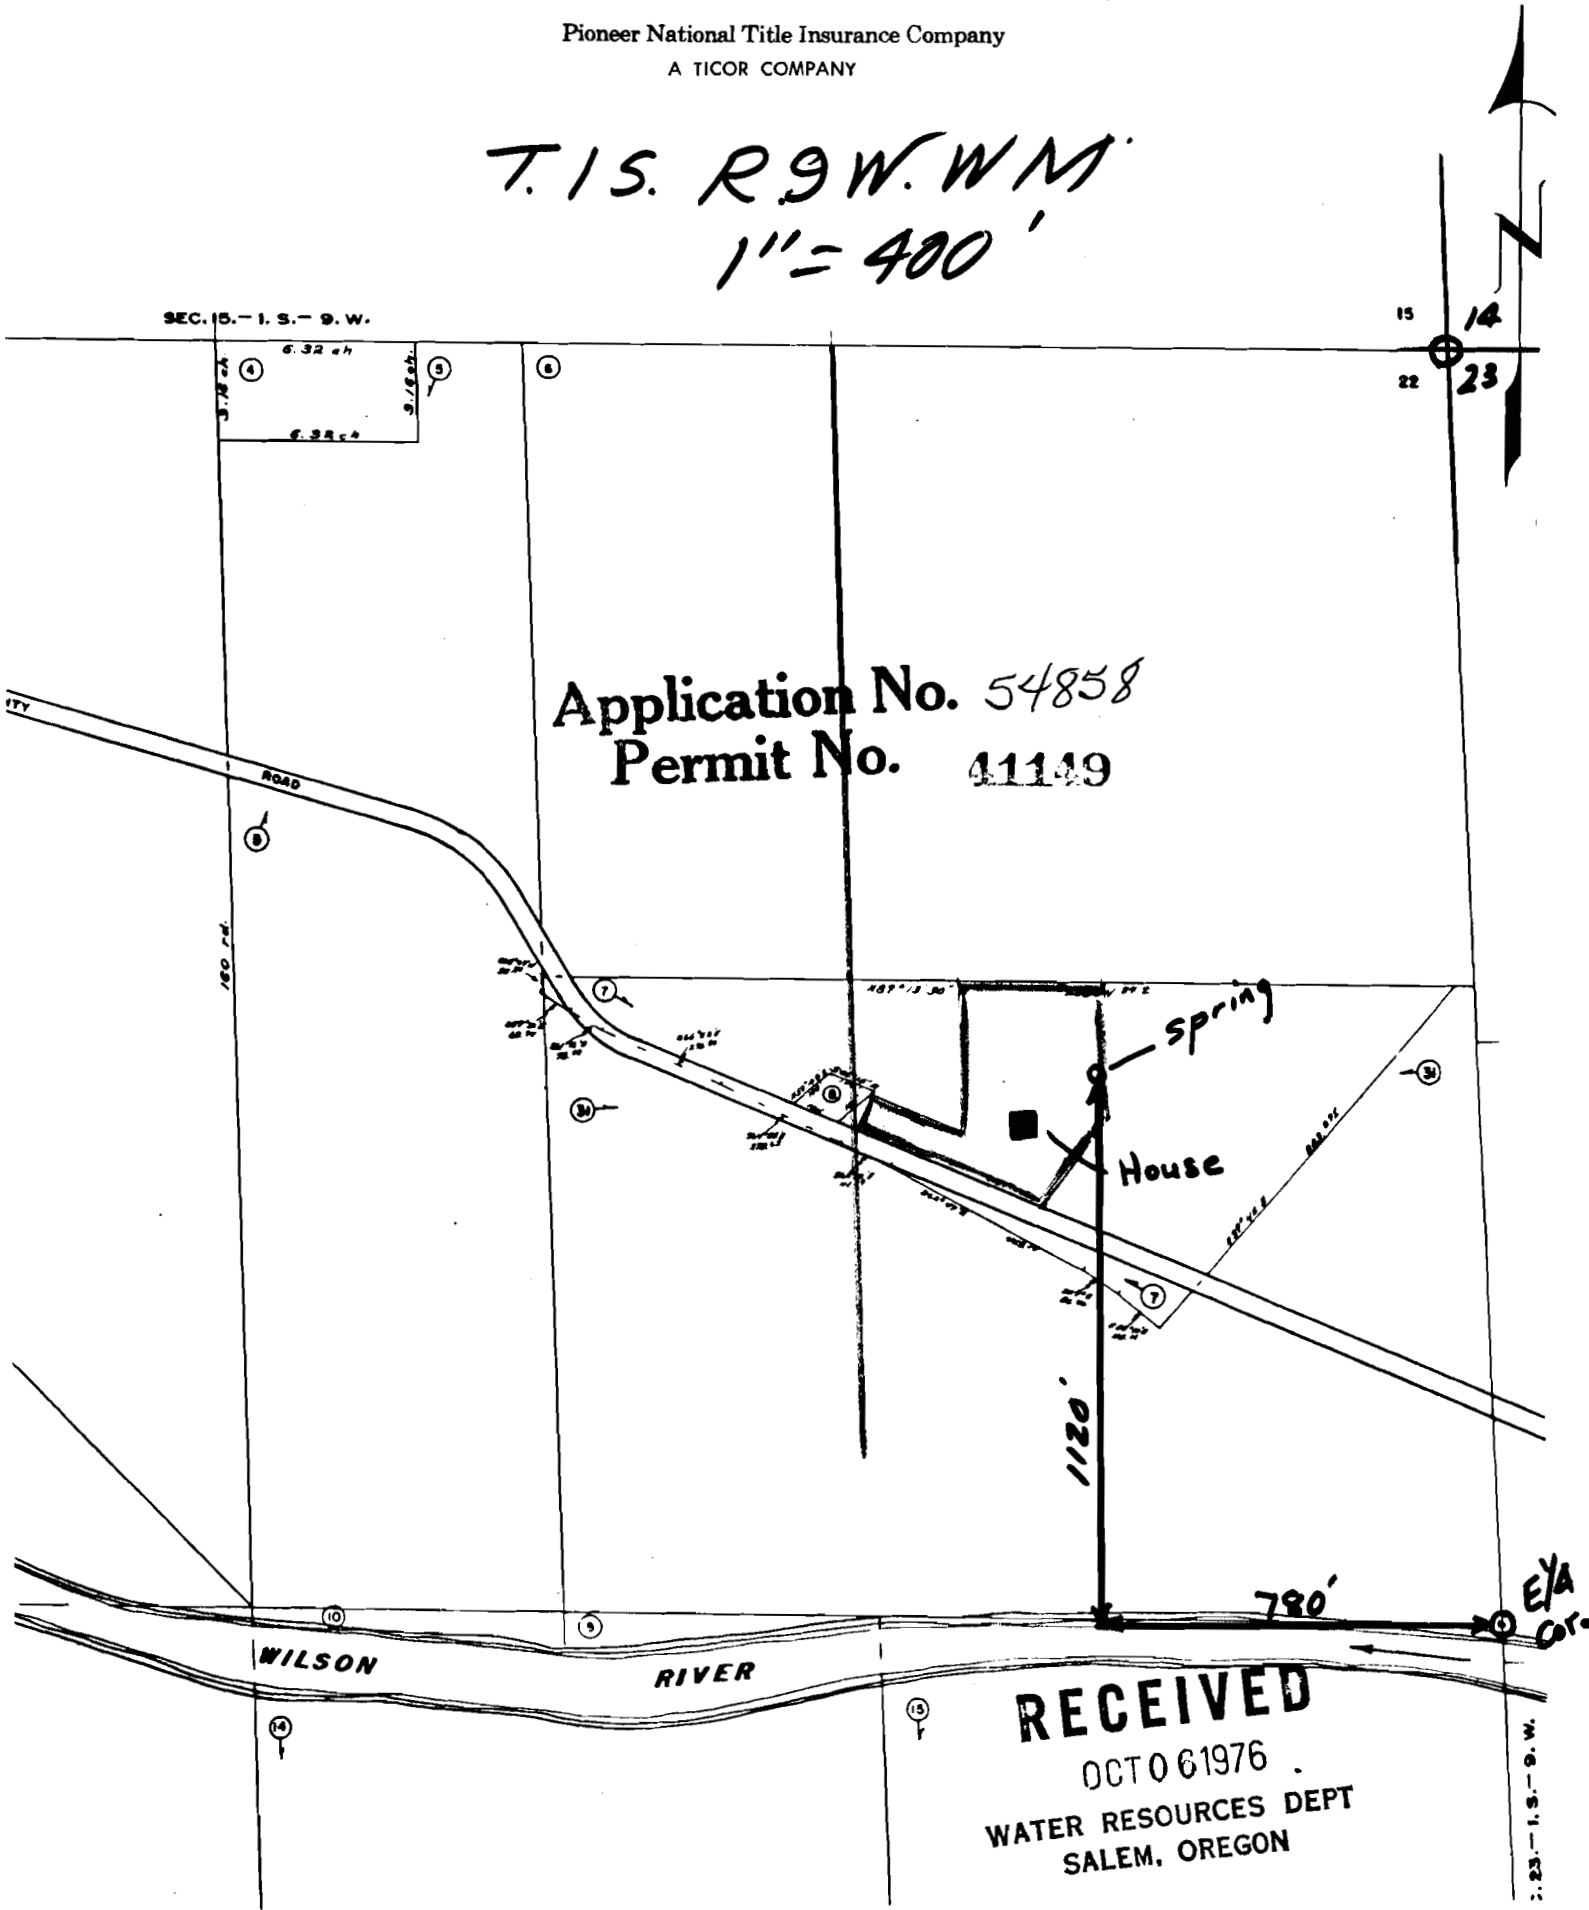

The sketch below is made solely for the purpose of assisting in locating said premises and the Company assumes no liability for variations, if any, in dimensions and location ascertained by actual survey.

Pioneer National Title Insurance Company
A TICOR COMPANY

RECEIVED

T. 1 S. R. 9 W. W. M.
1" = 400'


FEB 17 1982

WATER RESOURCES DEPT
SALEM, OREGON

SEC. 15 - T. 1 S. - R. 9 W.

15 14
22 23

Application No. 54858
Permit No. 41149

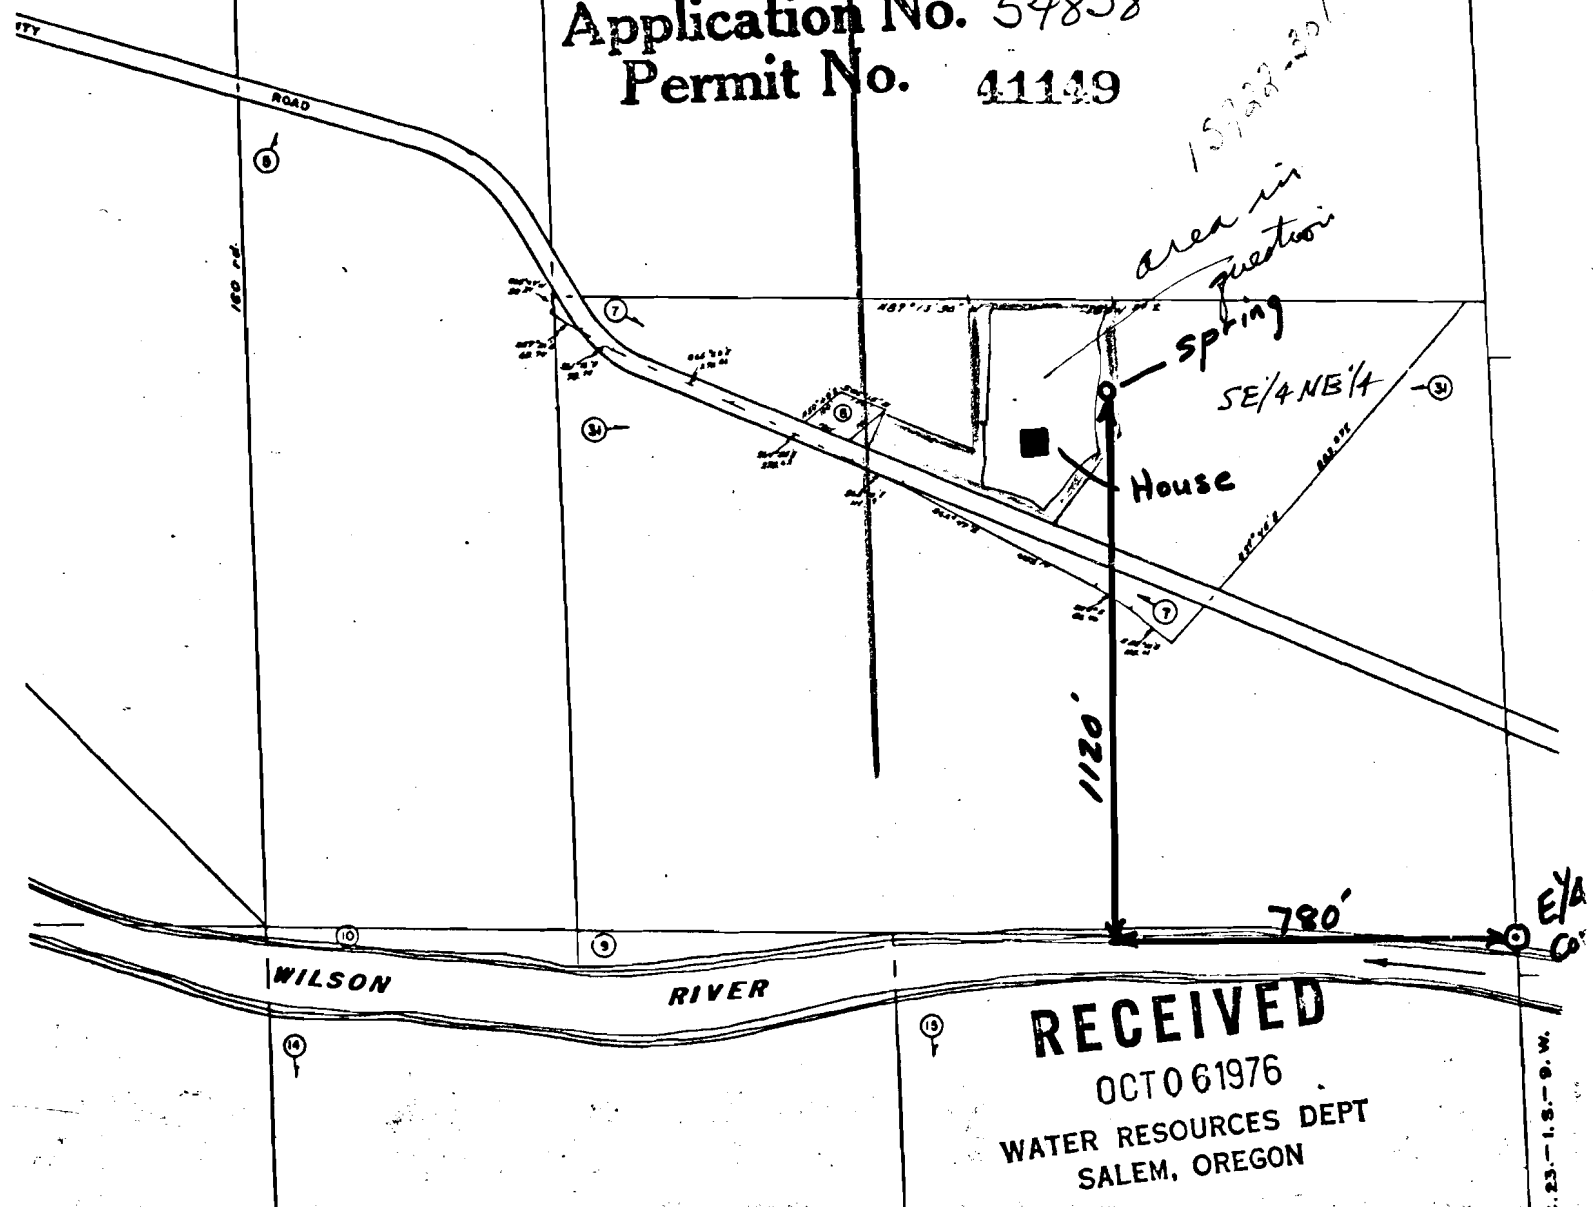

RECEIVED

OCT 06 1976
WATER RESOURCES DEPT
SALEM, OREGON

15
14
22
23
E/A
0'
T. 1 S. - R. 9 W.