


T. 16 S., R. 19 E., W.M.

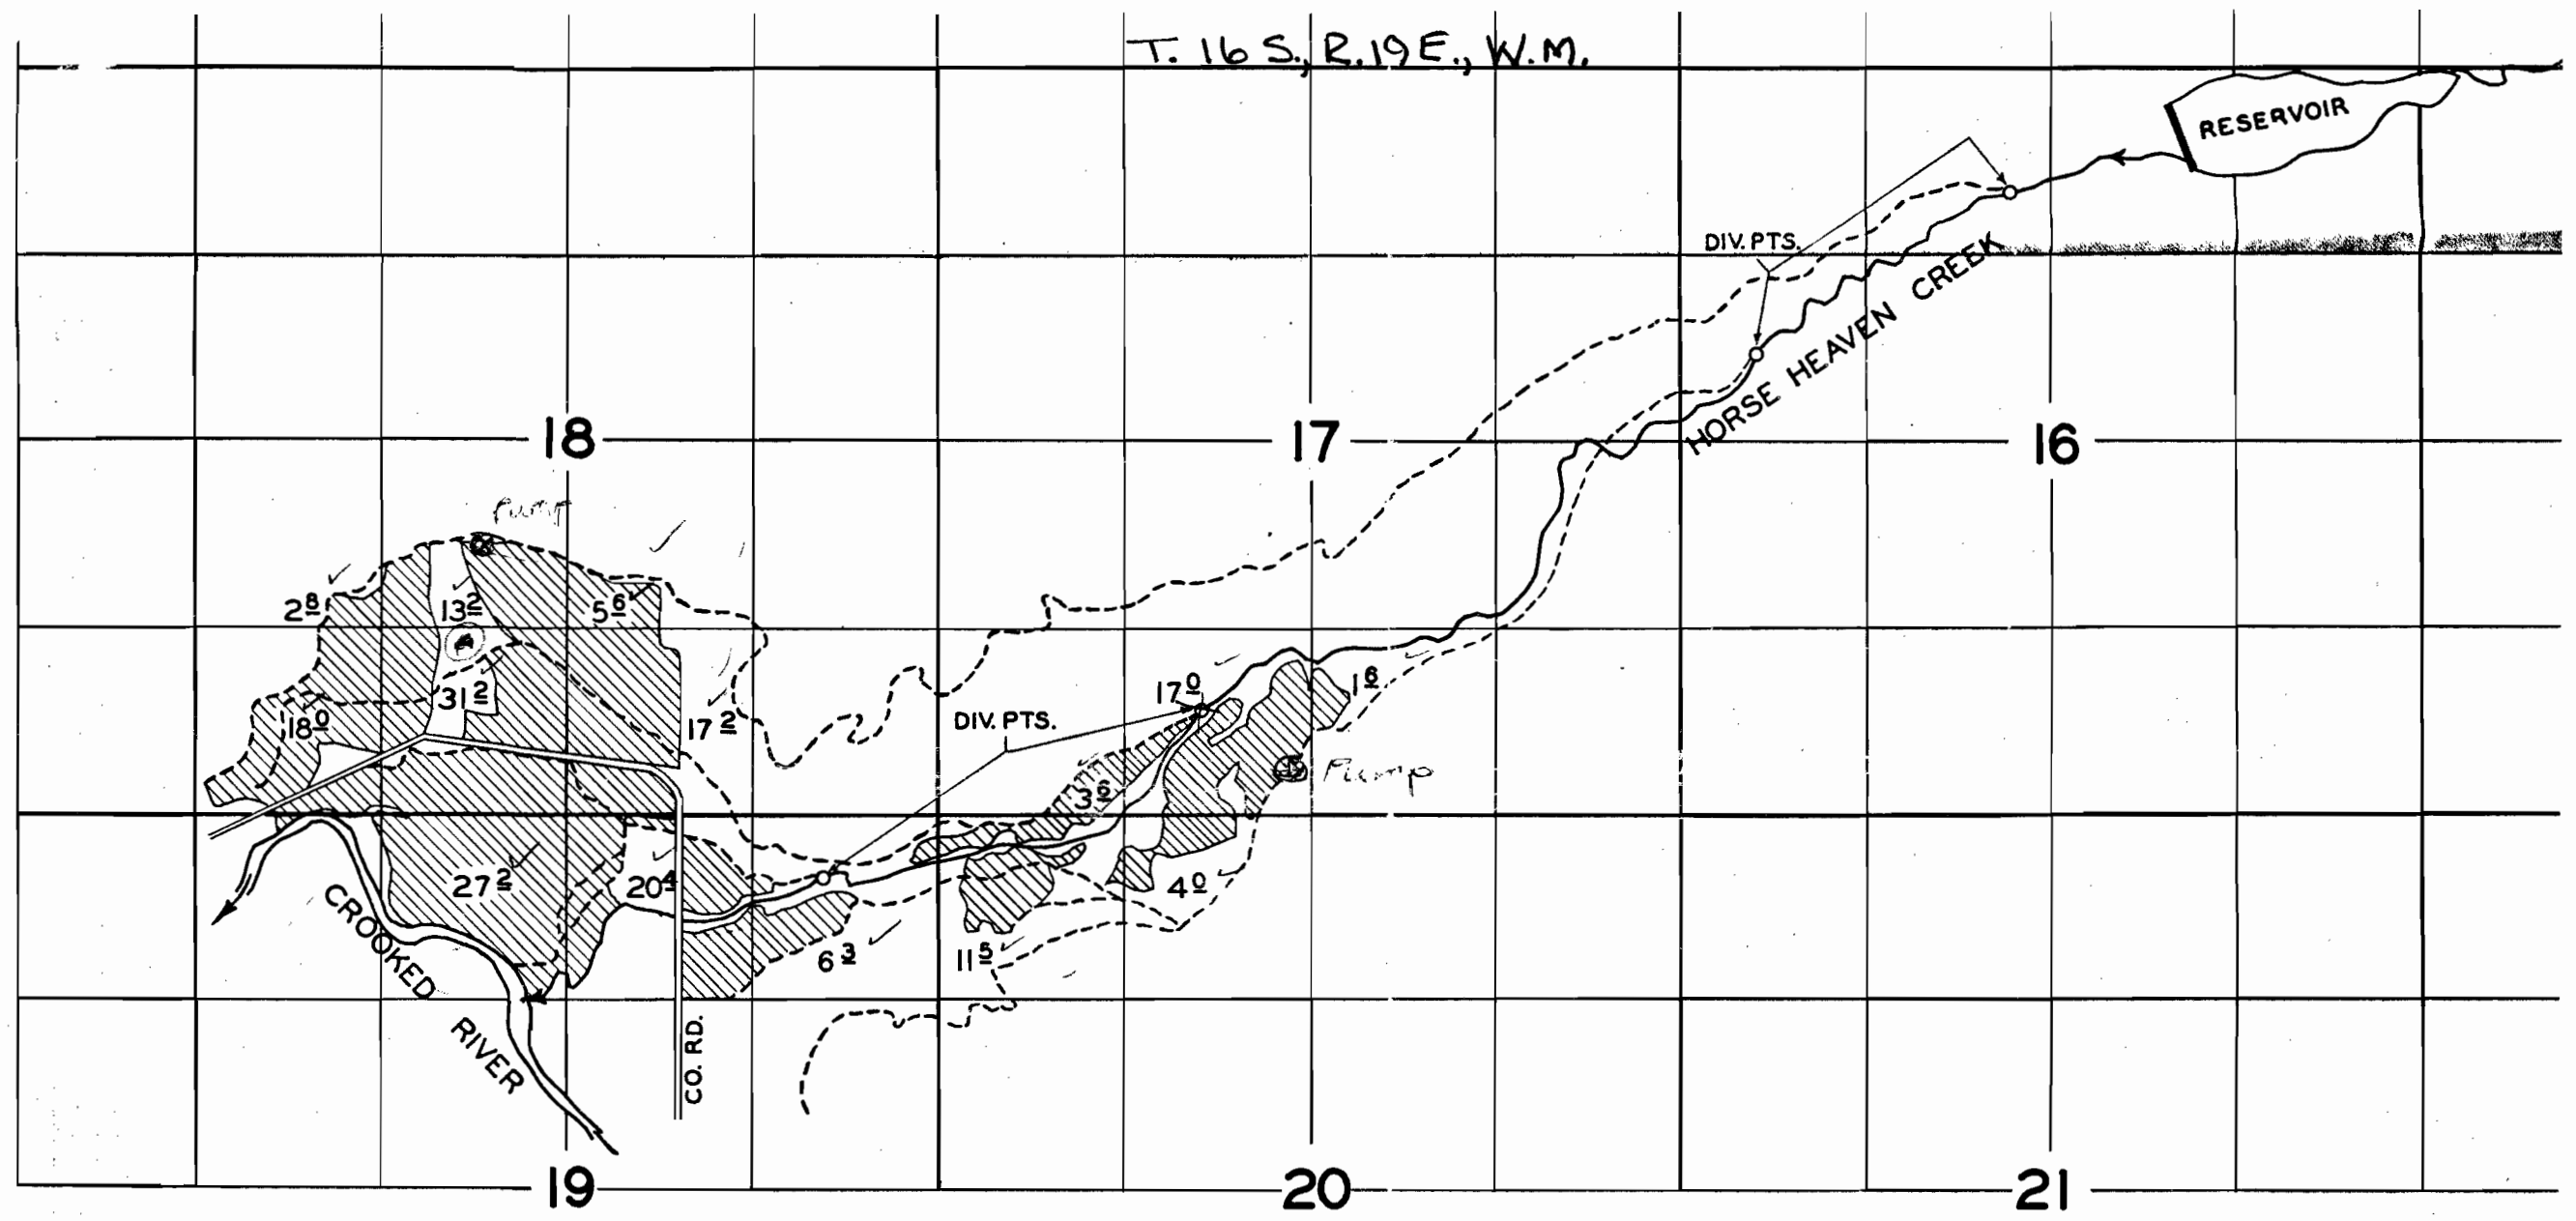

FINAL PROOF SURVEY

UNDER
 R-24957 R-1130
 Application No. 24958 Permit No. 20200

IN NAME OF
Hudspeth Land & Livestock Co.
 Surveyed AUG 7 1957

Copy