


T.1N., R.1W., M M

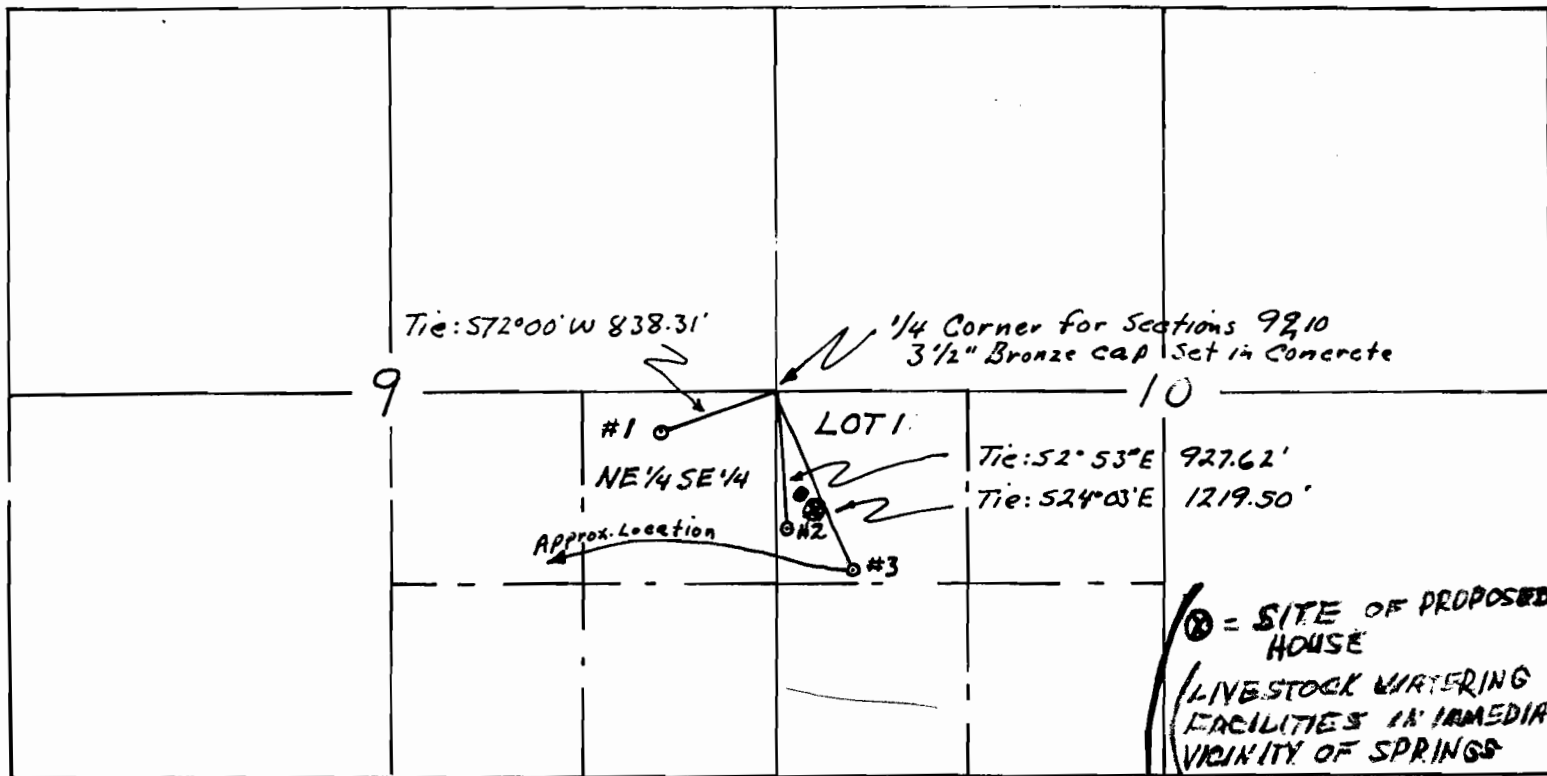

(UNNAMED)

Note: # 1 & 2 are springs - no out flow
3 is in head of small spring branch
below culvert below old County Road
(UNNAMED STREAM)

RECEIVED
MAY 1976
WATER RESOURCES DEPT.
MULTNOMAH COUNTY

Water Right Survey for:
JAMES BULLOCK
IN
NE 1/4 SE 1/4 Section 9 & LOT 1, Section 10
IN
T.1N., R.1W., WM
Multnomah County, Oregon

↑
MB N

ATTACHMENT (B)

June 14, 1976
Scale: 1" = 1320 ft.

by: H. J. Russell

RECEIVED
MAY 1976
WATER RESOURCES DEPT.
MULTNOMAH COUNTY

Application No. 54578
Permit No. 41182