


T. 37 S., R. 7 W., W. M.

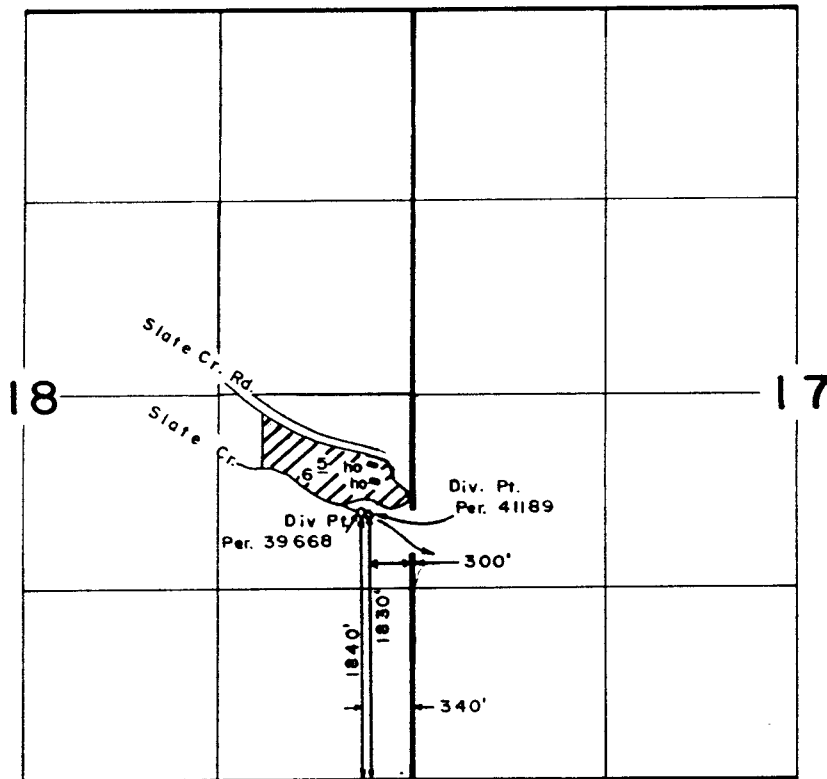

MAY 23 1989

WILLIAMS &  
GAYNE, INC.

Scale: 1" = 1320"

**FINAL PROOF SURVEY**  
UNDER

52614                      39668  
Application No. 54912      Permit No. 41189  
IN NAME OF

**NORMAN E. & DAISY T. BILLER**

Surveyed JUL. 23. 1986, by B. S. JAMES.

41033-179-197A

L.M.J.