


WATER RIGHTS APPLICATION:
JOHN BACKSTRAND
RT1, BOX 234, NEHALEM, ORE,
97131
TILLAMOOK CO

- = HOUSE
- = POINT OF DIVERSION
- = UNNAMED STREAM
- = PIPELINE

SECTION 13 T3N R10W WM
SEE MAP 3N 10 12

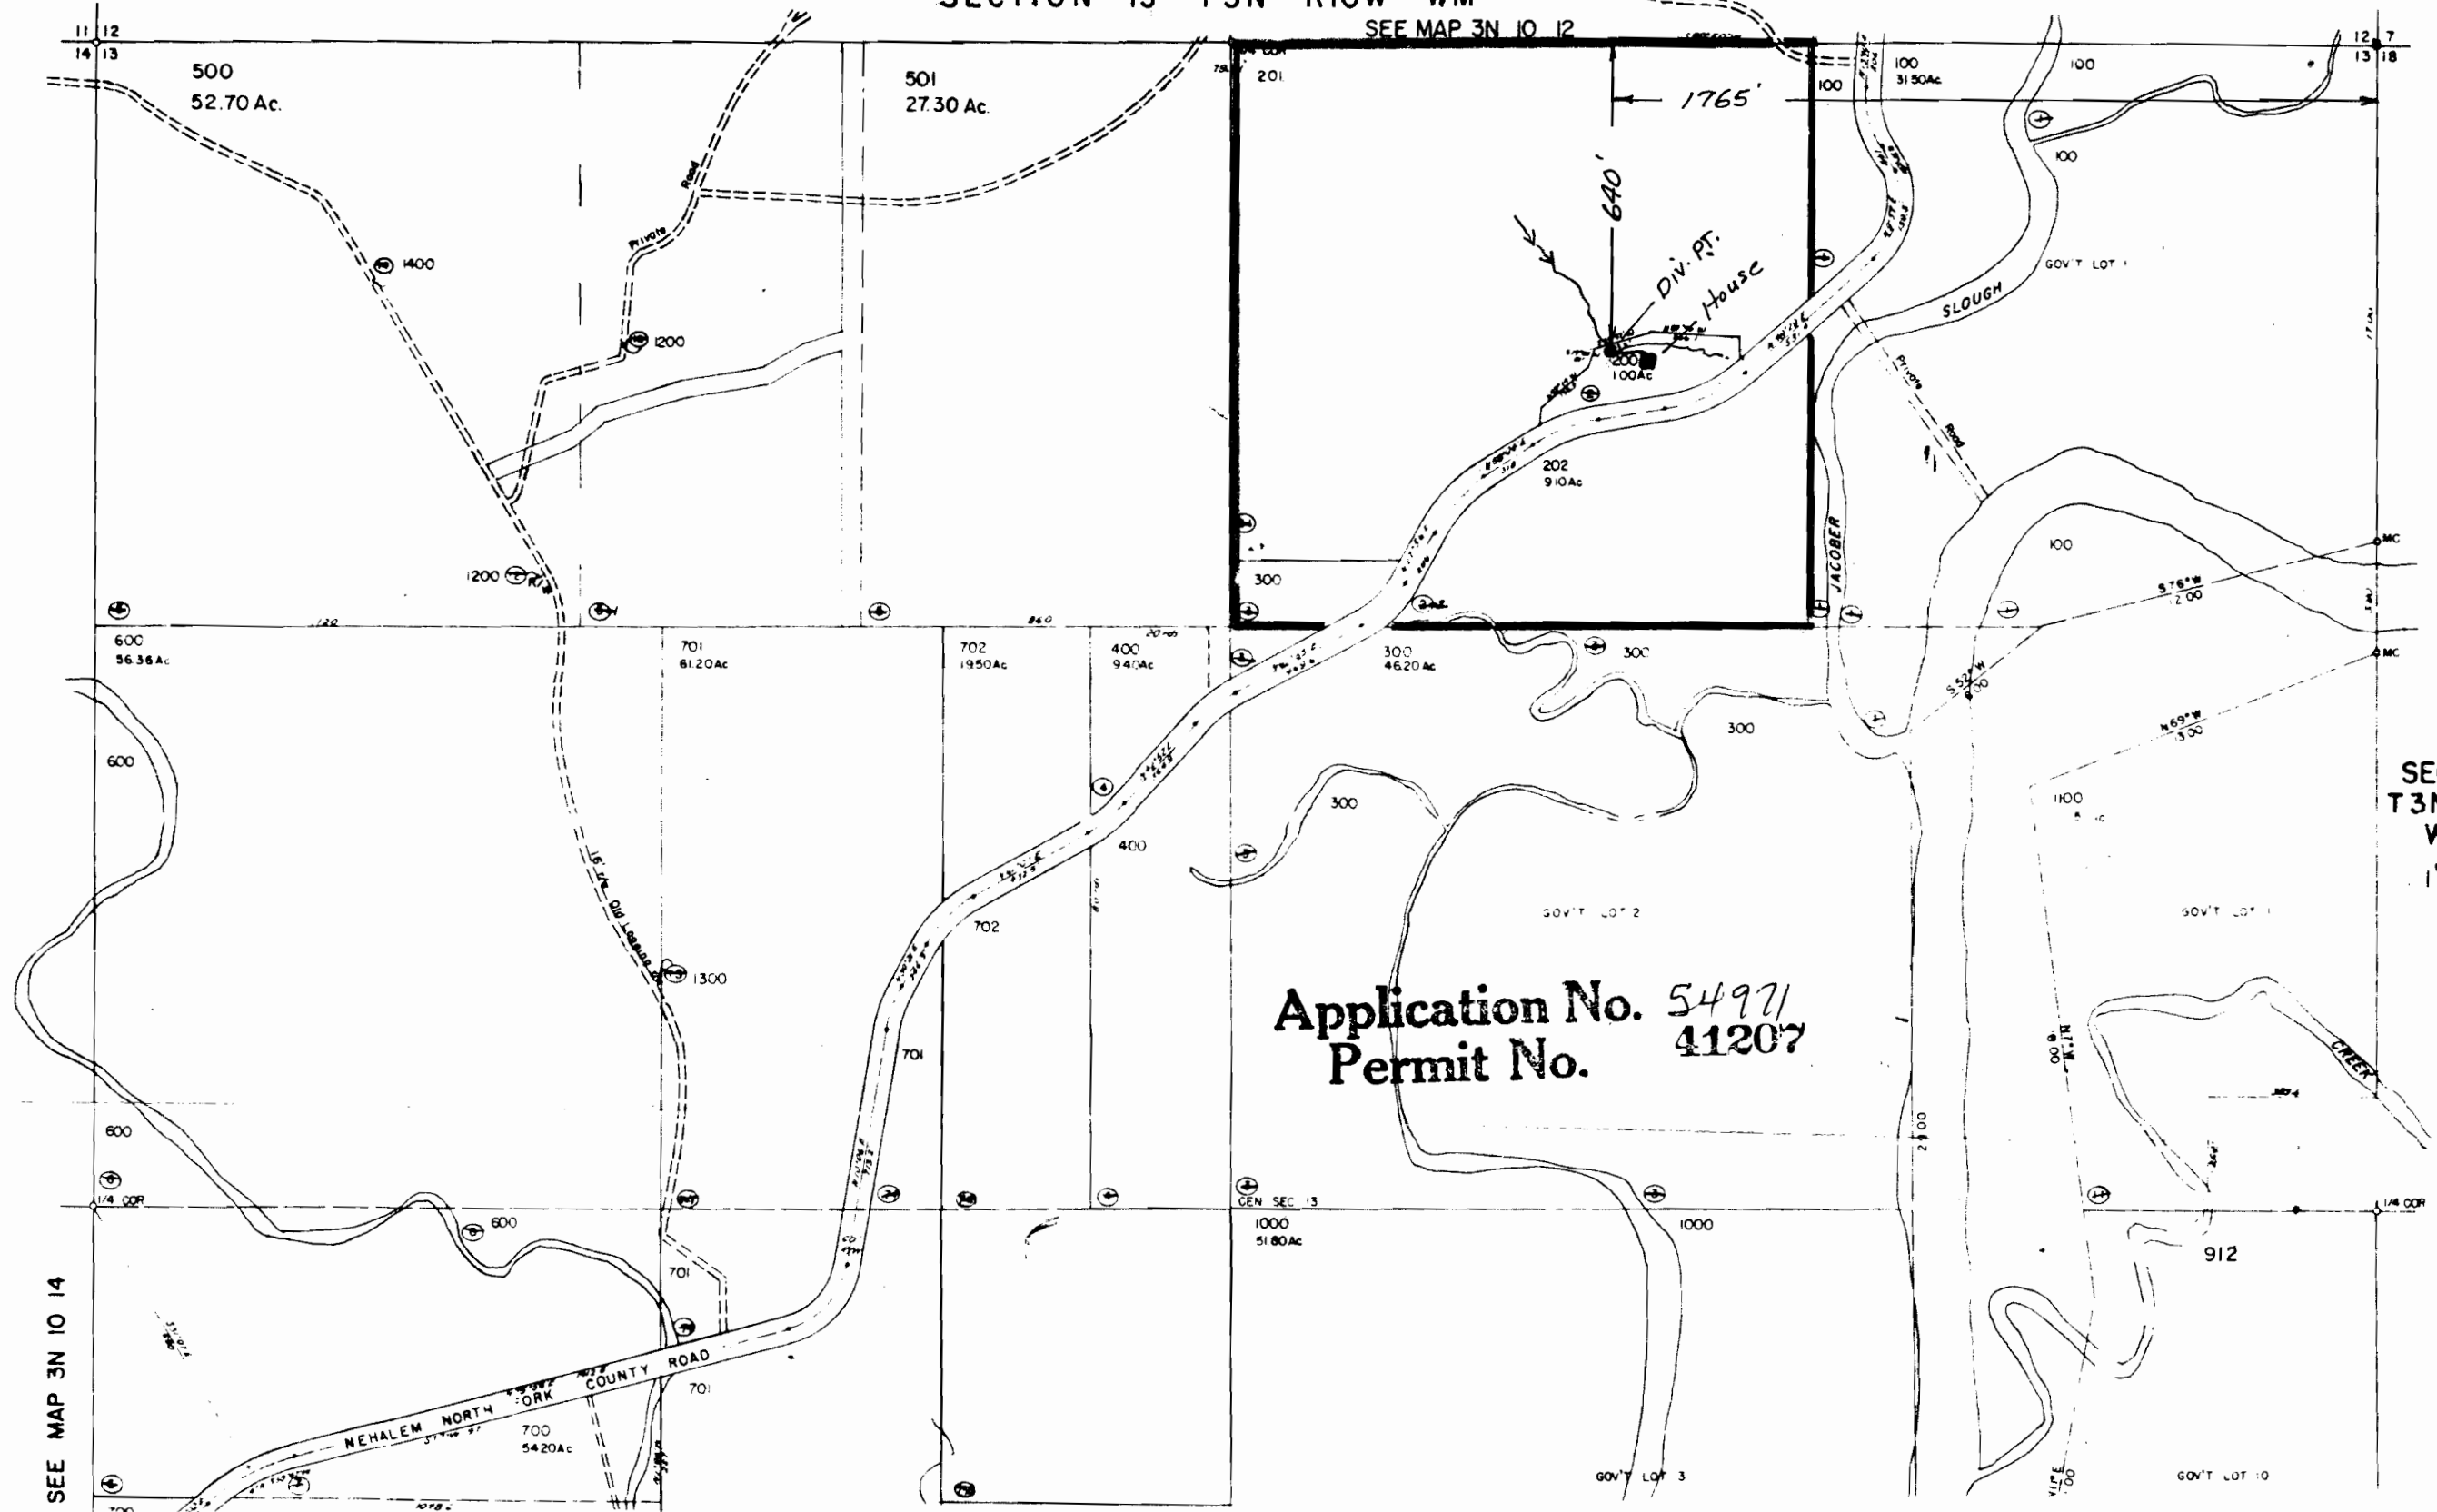

Application No. 54971
Permit No. 41207

SEC. 13
T3N R10W
WM
1" = 400'

SEE MAP 3N 9 18

SEE MAP 3N 10 14

RECEIVED
NOV 1 1978
WATER RESOURCES DEPT
SALEM, OREGON