


T. 34 S., R. 5 W., W.M.

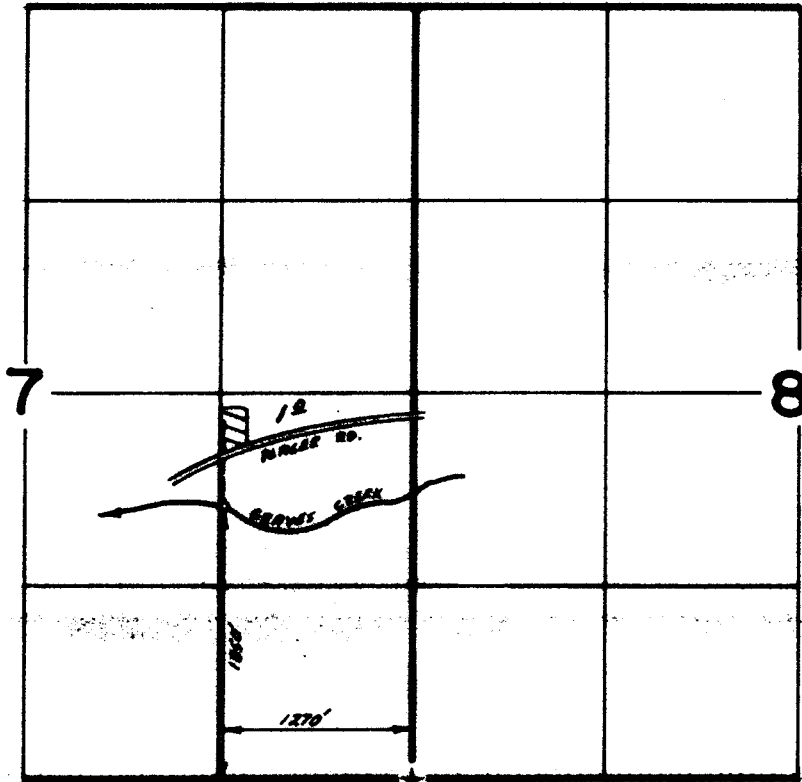

Scale 1"=1320'

RECEIVED

AUG 17 1988

WM. DIST. 1"
GRANTS PASS, ORG.

FINAL PROOF SURVEY
UNDER

Application No. 54998 Permit No. 41211.....
IN NAME OF

.....JOE R. BEAUDRO.....

Surveyed Aug. 13, 1986, by B.S. JAMES.....

41033-178-131 R