


T. 33 S., R. 6 W., W. M. # 41235

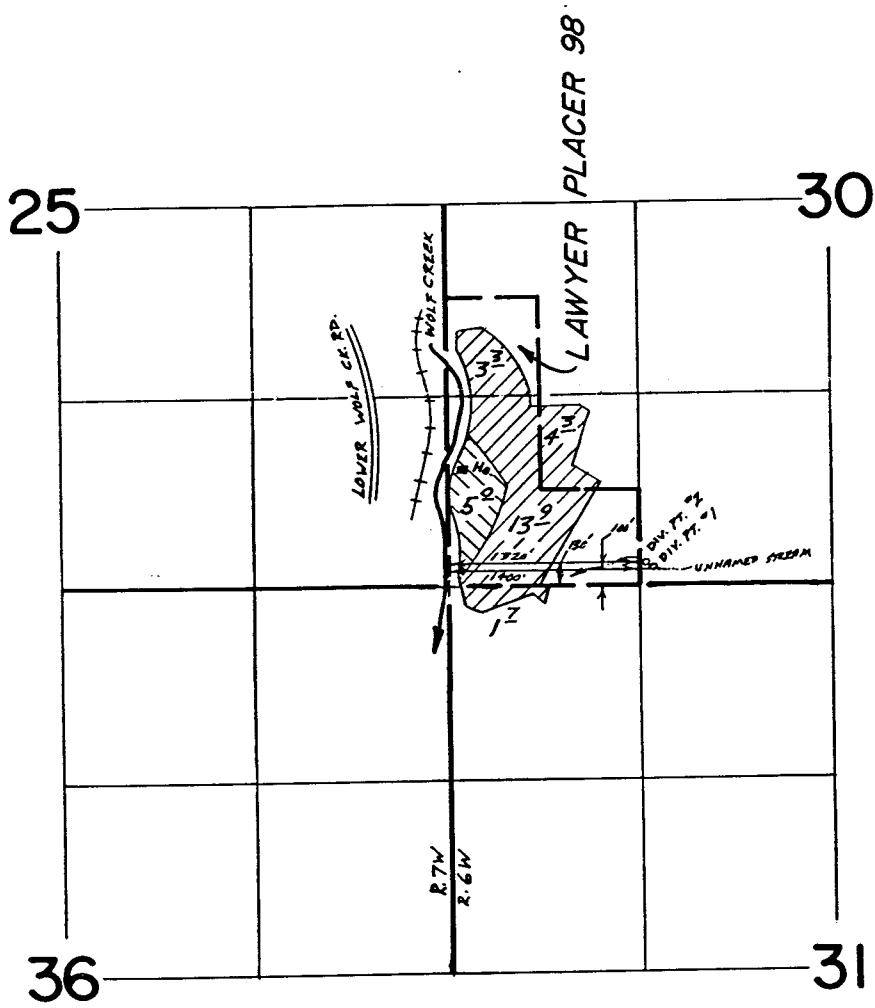

Scale 1"=1320' SUPPLEMENTAL

PRIMARY

- Primary
- Supplemental

FINAL PROOF SURVEY UNDER

Application No. 54888. Permit No. 41235.....
IN NAME OF

.....NOMENUS, INC.....

Surveyed August 28 1984, by J.R. WOODRUFF.