


T. 37 S., R. 7 W., W.M.

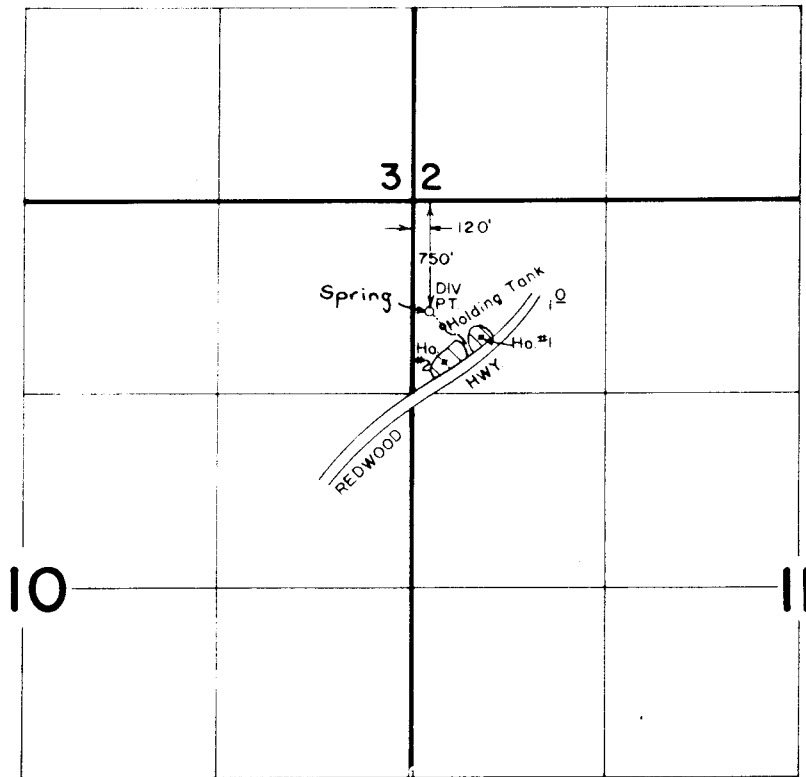

RECEIVED

NOV 8 1988

W.M. DIST. 14
GRANTS PASS, ORE.

FINAL PROOF SURVEY
UNDER

Application No. 54949 Permit No. 41241
IN NAME OF

DALE S. GREEN

Surveyed OCT. 24 1983, by B. S. JAMES

SCALE: 4" = 1 MILE

179-170L

TWB